


T. 26 S. R. 3 W. W.M.

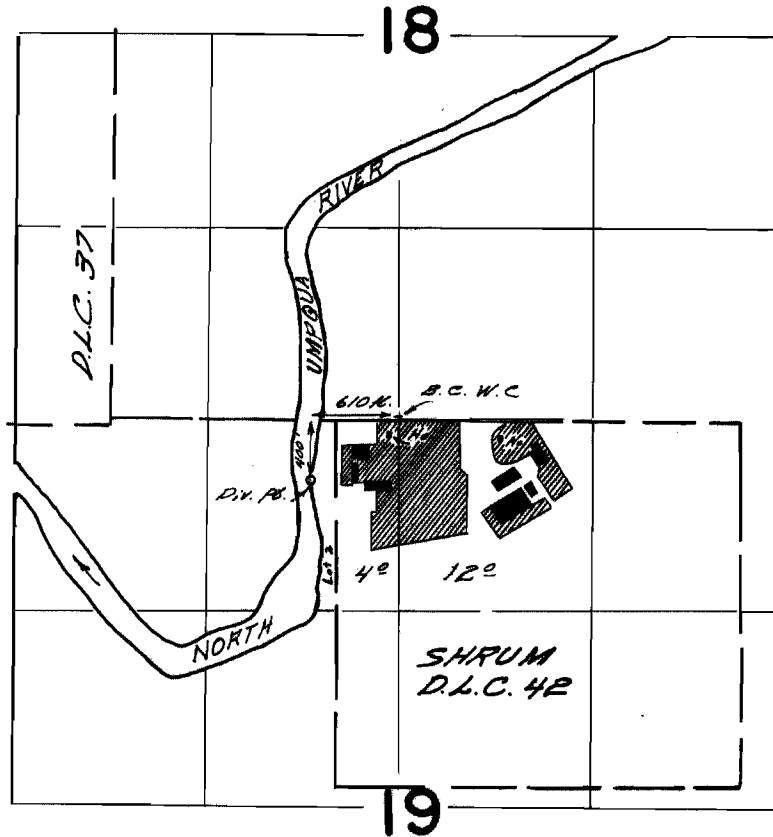

FINAL PROOF SURVEY
UNDER

Application No. 39682 Permit No. 29622
IN NAME OF

DOUGLAS Co. SCHOOL DIST No 12

Surveyed April 20 1967, by H. d. Ruppert.