


# T. 28S. R. 7W. W.M.

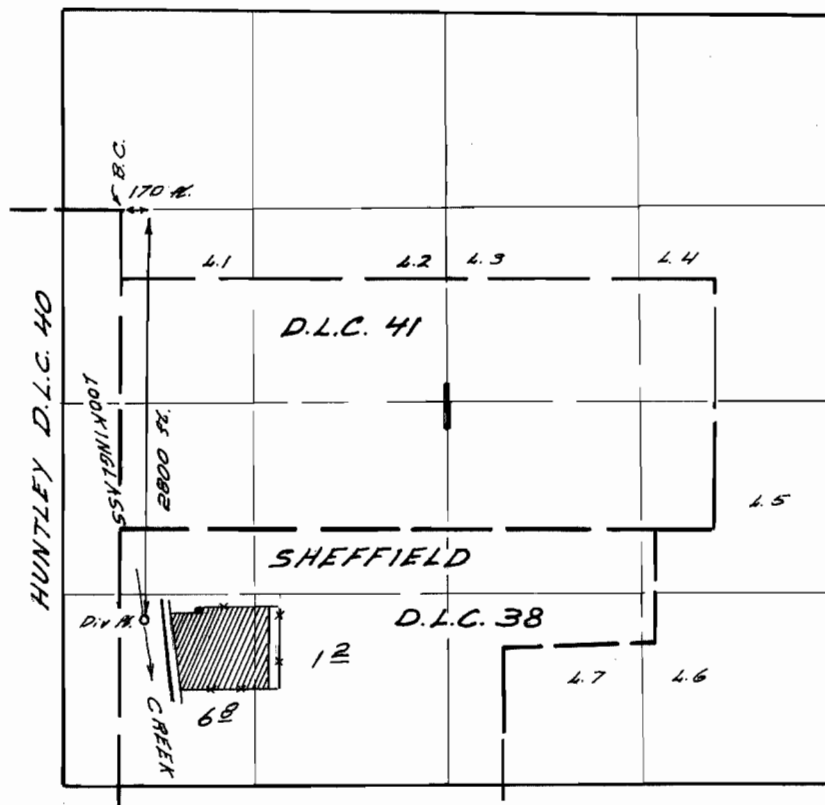

## FINAL PROOF SURVEY UNDER

Application No. 3990.3 Permit No. 29701  
IN NAME OF

Raymond Buell

Surveyed June 5, 1967, by W.D. Ruppert