


T. 24 & 25 S. R. 5 W. W.M.

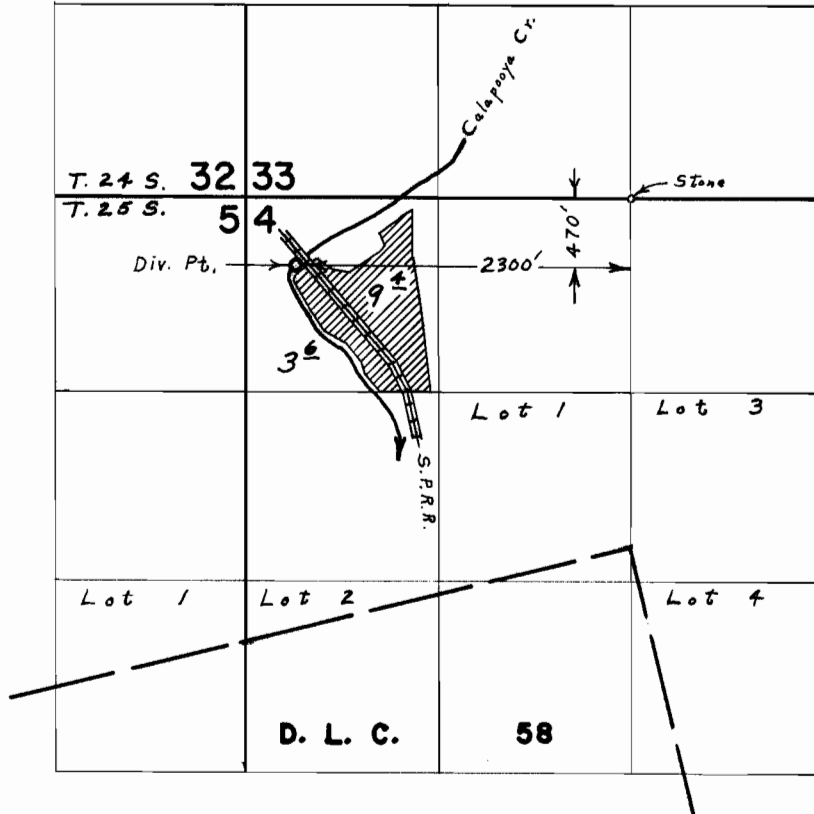

FINAL PROOF SURVEY
UNDER

Application No. 40022 Permit No. 29807
IN NAME OF
DELBERT G. UPTON

Surveyed June 8, 1967, by L. E. Gould