


T. 24 & 25 S. R. 5 W. W.M.

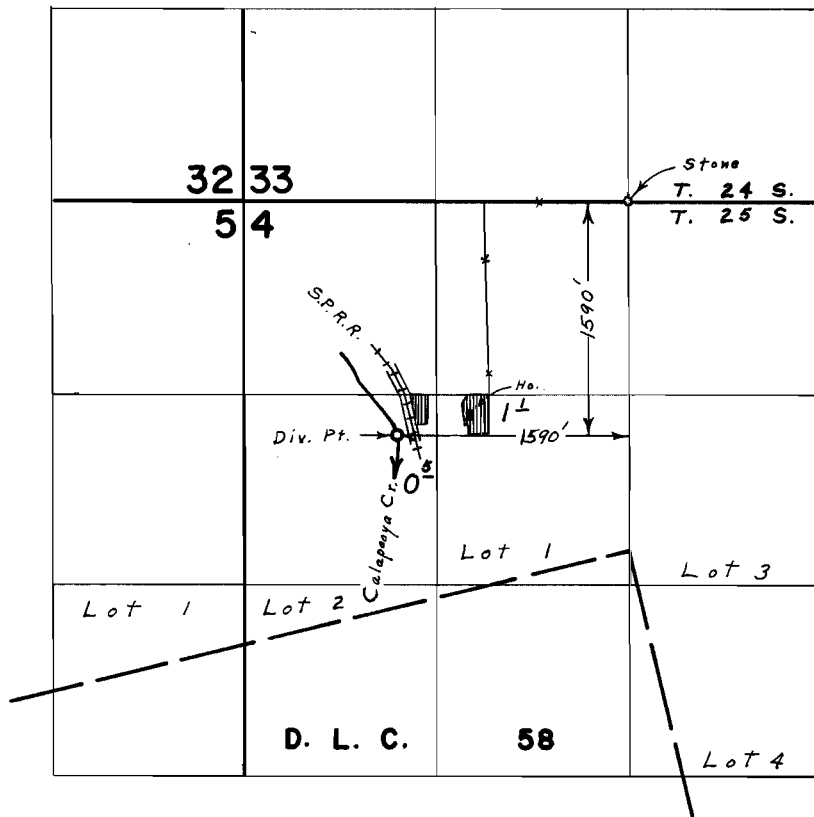

FINAL PROOF SURVEY UNDER

Application No. 41134 Permit No. 30667
IN NAME OF

TED LEGORE

Surveyed June 8, 1967, by L. E. Gould