


T. 24 S. R. 7 W. W.M.

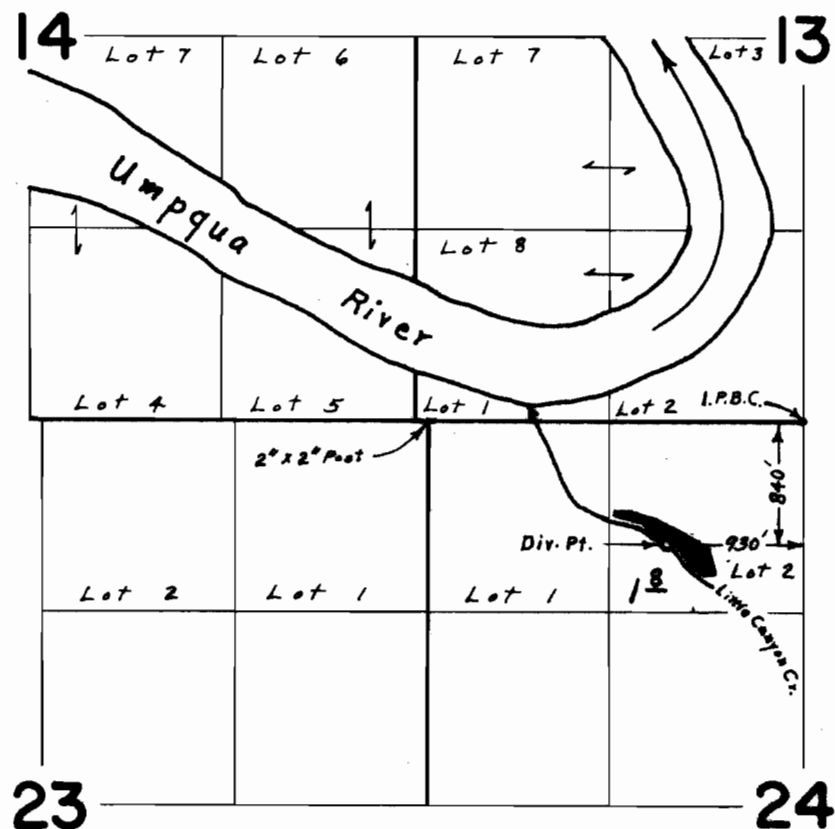

FINAL PROOF SURVEY
UNDER

Application No. 41444 Permit No. 30950
IN NAME OF

T. J. & AVA E. COONEY

Surveyed June 13, 1967, by L. E. Gould