


# T. 24 S. R. 7 W. W.M.

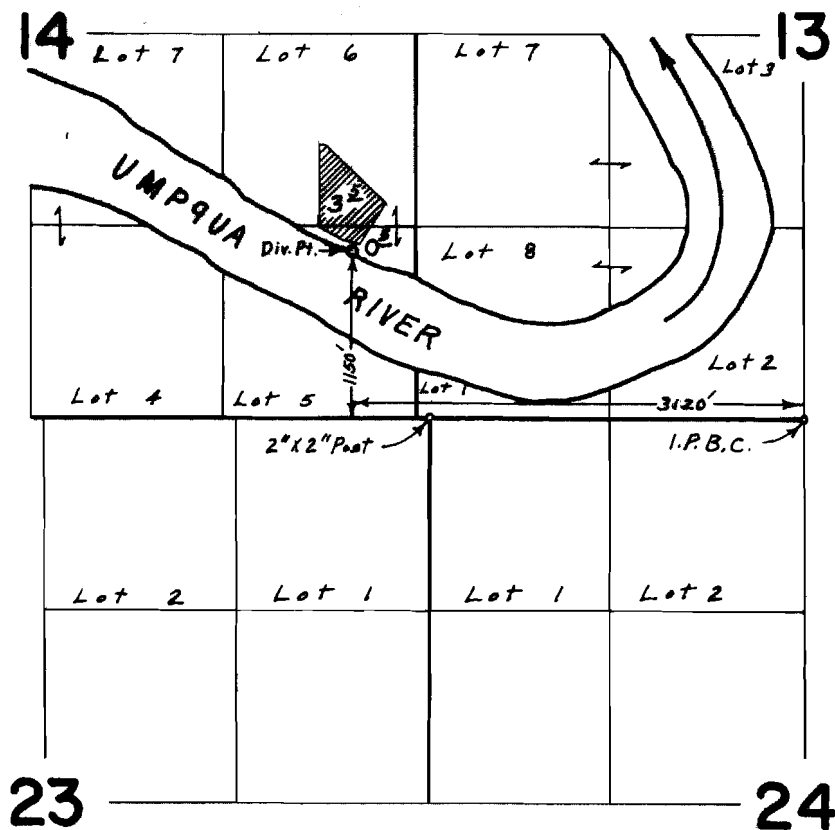

## FINAL PROOF SURVEY UNDER

Application No. 41546 Permit No. 30991  
IN NAME OF

AUBREY MARTIN McMAHON

Surveyed June 13, 1967, by L. E. Gould