


T.25 S. R.7W. W.M.

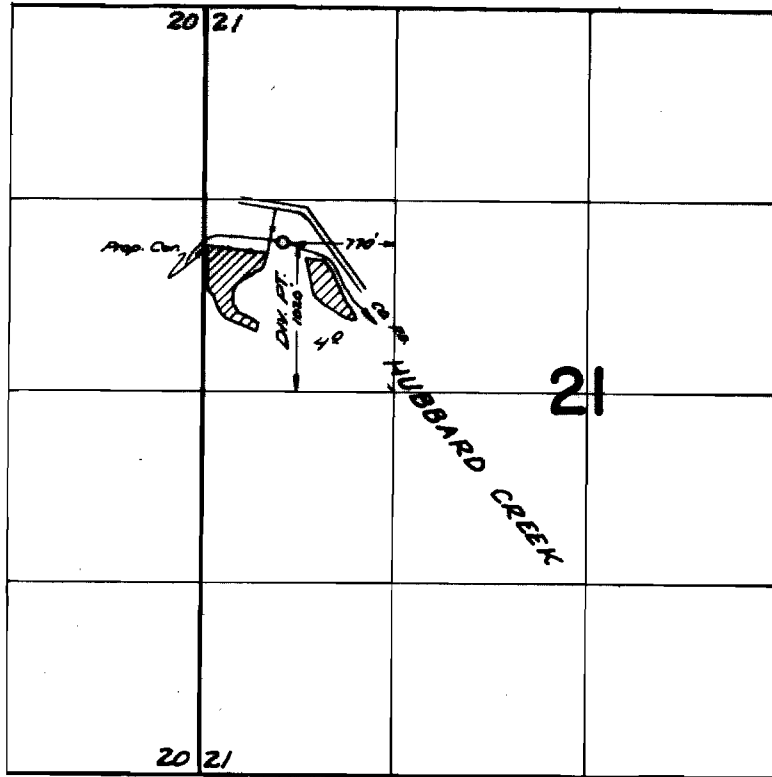

FINAL PROOF SURVEY
UNDER

Application No. 41566 Permit No. 31007
IN NAME OF

C.A. BUCKNELL

Surveyed June 16, 1967, by L.E. Gould