


T. 27S. R. 6W. W.M.

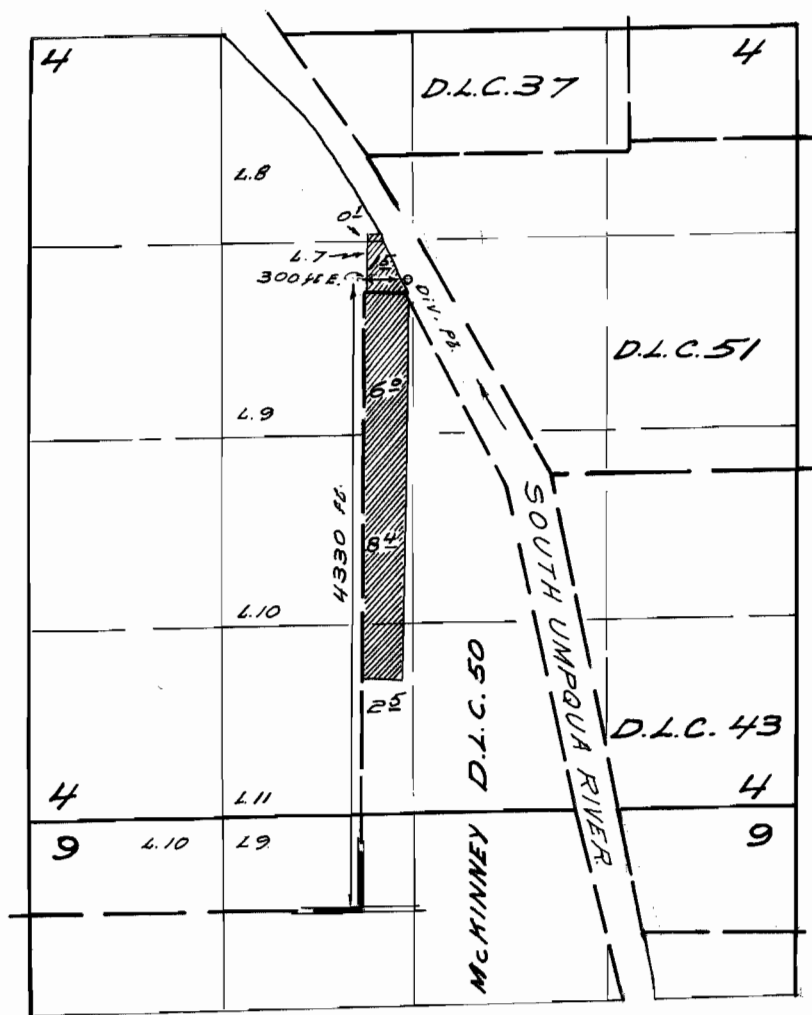

FINAL PROOF SURVEY
UNDER

Application No. 41758 Permit No. 31172
IN NAME OF

Byron Belmont

Surveyed July 13 1967, by W. J. Ruppert