


T. 24 & 25 S. R. 5 W. W.M.

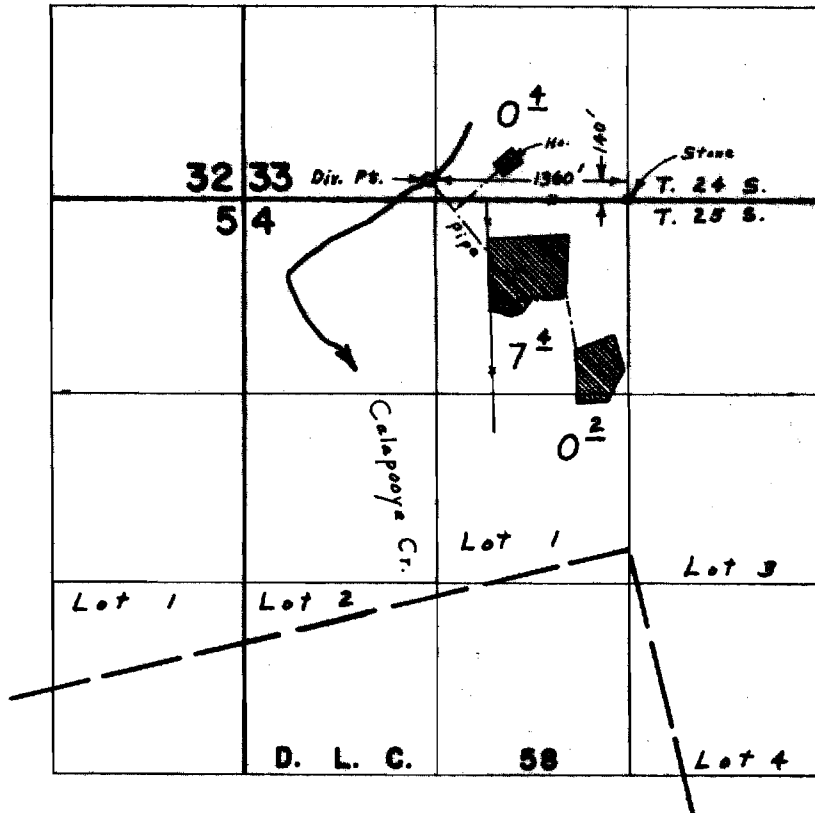

FINAL PROOF SURVEY UNDER

Application No. 42068... Permit No. 3/486...
IN NAME OF

OAKLAND SCHOOL DIST. NO. 1

Surveyed June 8, 1967, by L. E. Gould