


T. 25 S. R. 7 W. W.M.

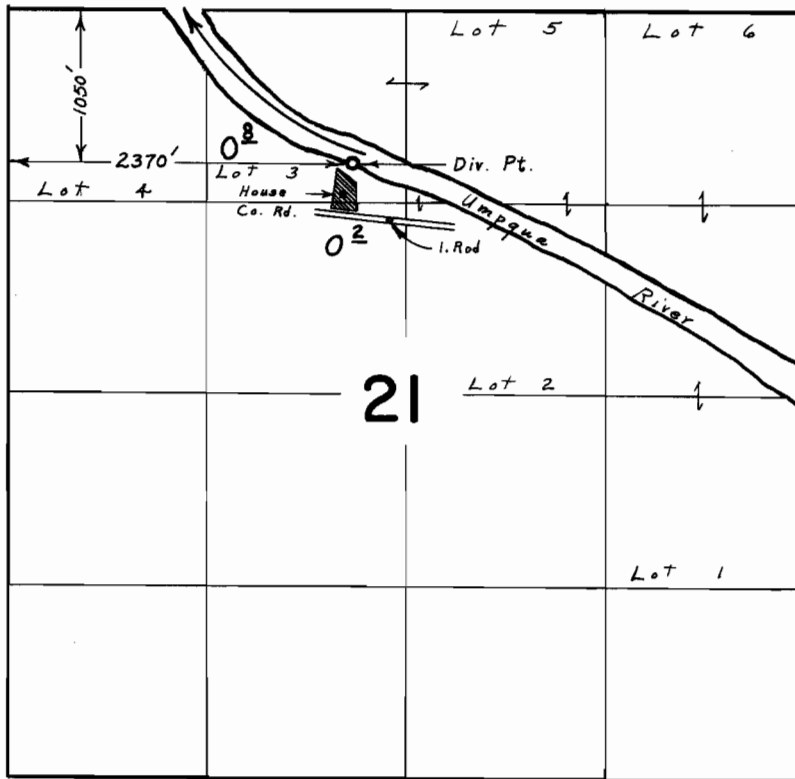

FINAL PROOF SURVEY
UNDER

Application No. 42266... Permit No. 31585...
IN NAME OF

ROBERT R. OR HELEN H. CAMPBELL

Surveyed June 6, 1967, by L. E. Gould