


T. 26 S. R. 5 W. W. M.

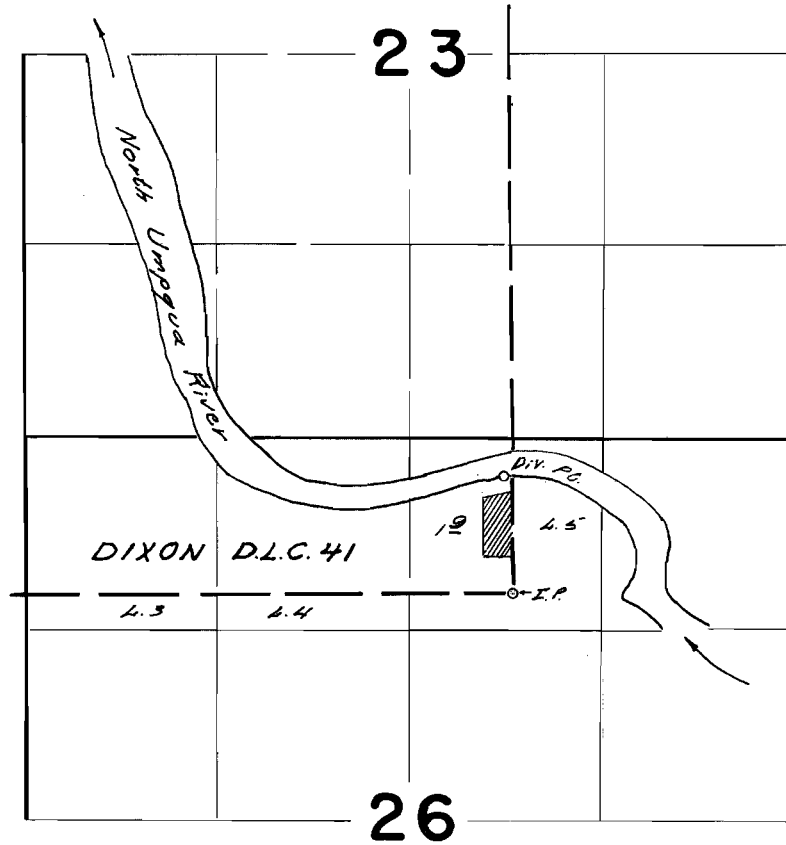

Diversion Point located 790 ft N. & 50 ft W. from
S.E. Corner D.L.C. 41

FINAL PROOF SURVEY
UNDER

Application No. 42313 Permit No. 31638
IN NAME OF

James D. Vasey

Surveyed May 10, 1967, by W.J. Ruppert