


T.23S. R.32 1/2 E.W.M.

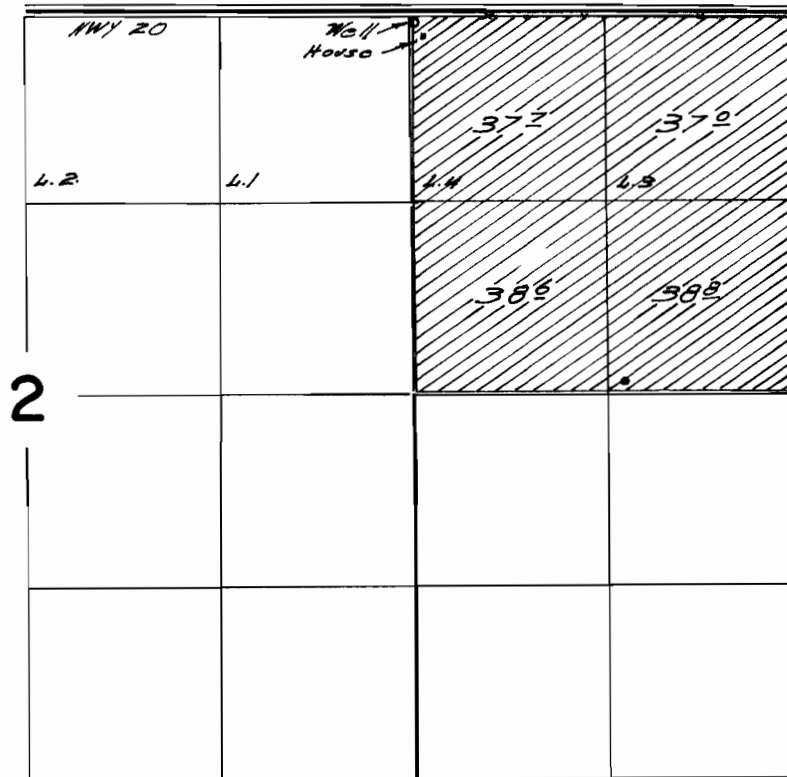

Well located 70 ft. S. & 30 ft. E. from N.W. Cor. Sec. 2.

FINAL PROOF SURVEY
UNDER

Application No. G-2611 Permit No. G-2451
IN NAME OF

Virginia A. Sanders, M. Vera & Edward A. McCorville

Surveyed July 26 1967, by *R. J. Ayer*