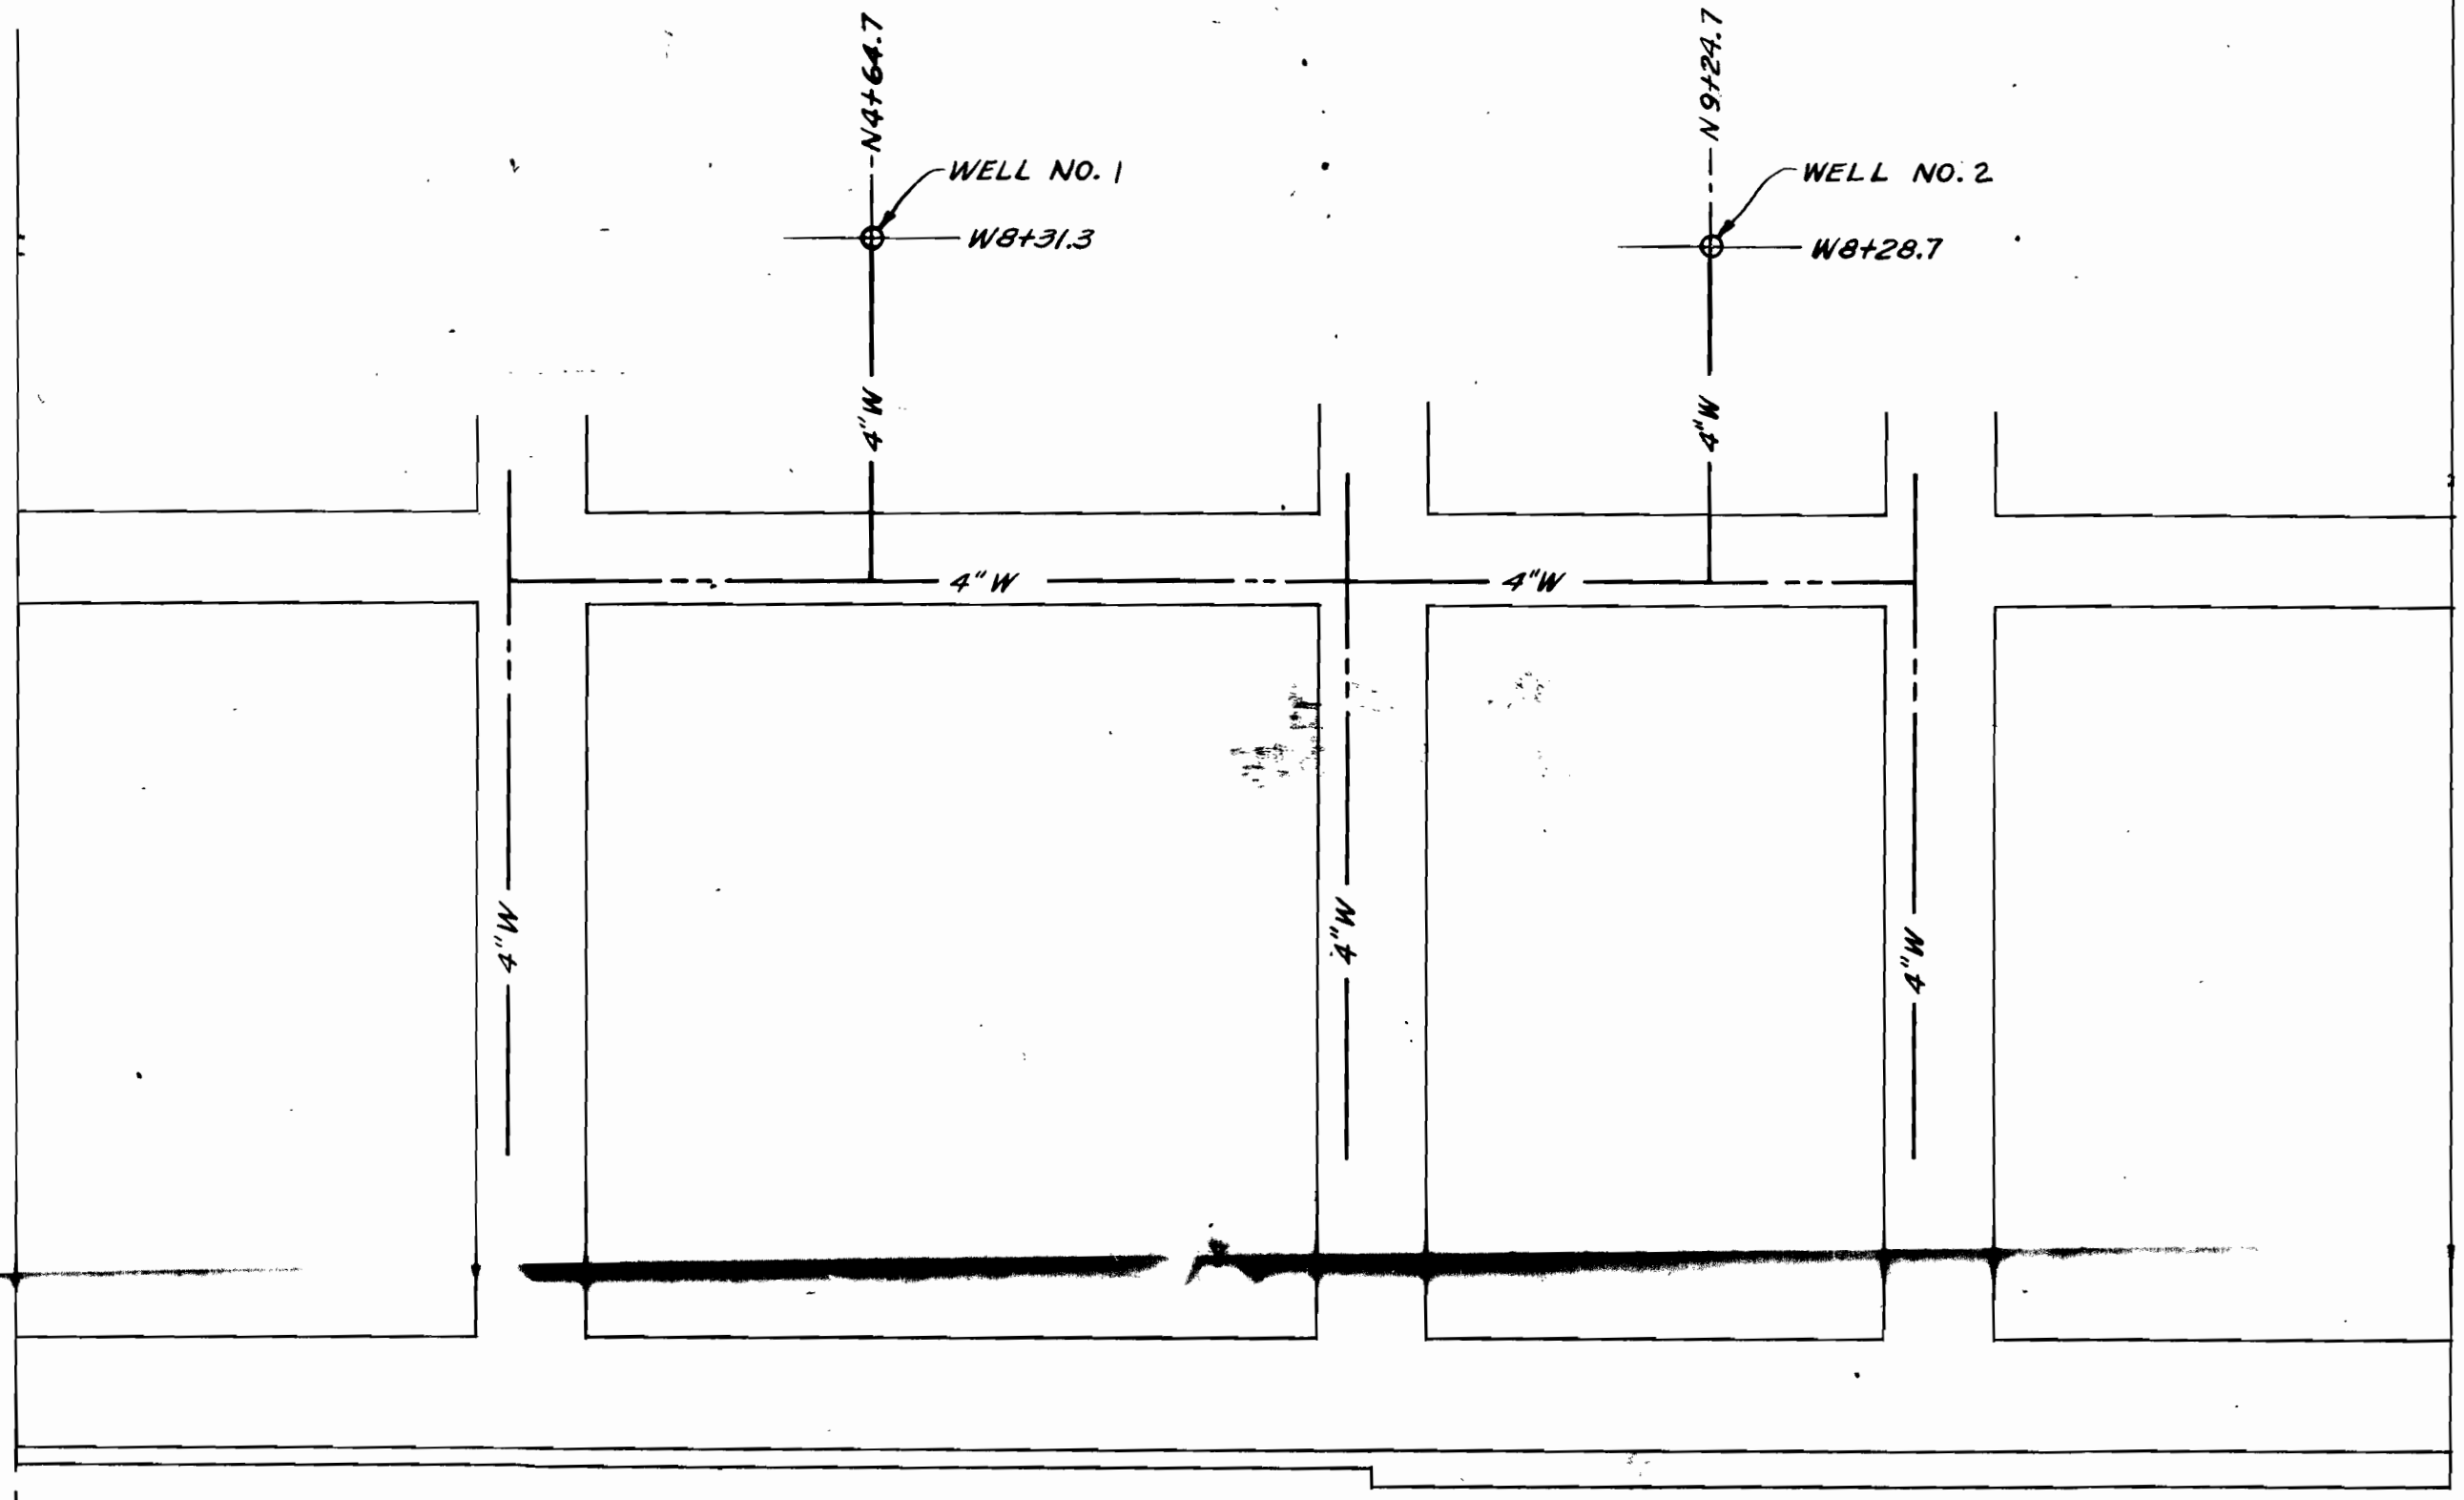

REGISTERED PROFESSIONAL ENGINEER
3818
OREGON
MAY 31, 1966
WILBUR L. WARREN

℄ CRATER LAKE HIGHWAY

SECTION 6
SECTION 5
¼ CORNER - 1" PIPE

Application No. G-3146
Permit No. G-2963

NOTE:
COORDINATES TAKEN FROM ¼ CORNER COMMON TO SECTIONS 5 & 6
TWP 37S, RGE 1W, W.M.

K-D INDUSTRIAL PARK
MEDFORD, OREGON

WATER WELL LOCATIONS

DES. WLW	WILBUR L. WARREN	SCALE	
DRAWN RGD DATE 6/10/65	CONSULTING CIVIL ENGINEER	1" = 100'	
CHK.	MEDFORD, OREGON	SHEET 1 OF 1	
		DWG. NO. 72-2	