


T.35S.R.1E.W.M.

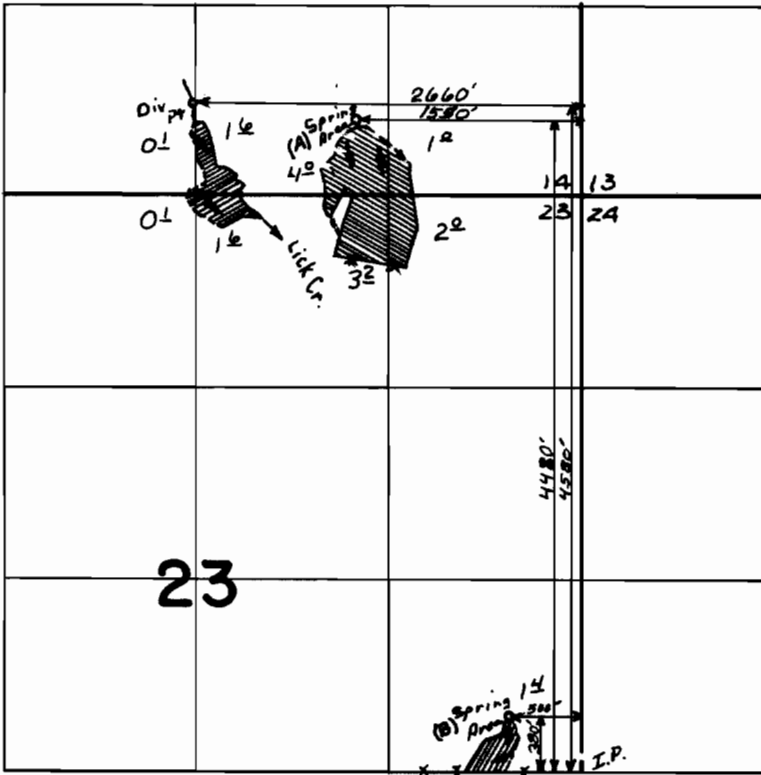

FINAL PROOF SURVEY

UNDER

Application No. 34658 Permit No. 27222
IN NAME OF _____

Sherman Feiss

Surveyed May 23 1967, by W. C. Ruppert.