


# T.37 & 38 S. R.3 W. W. M.

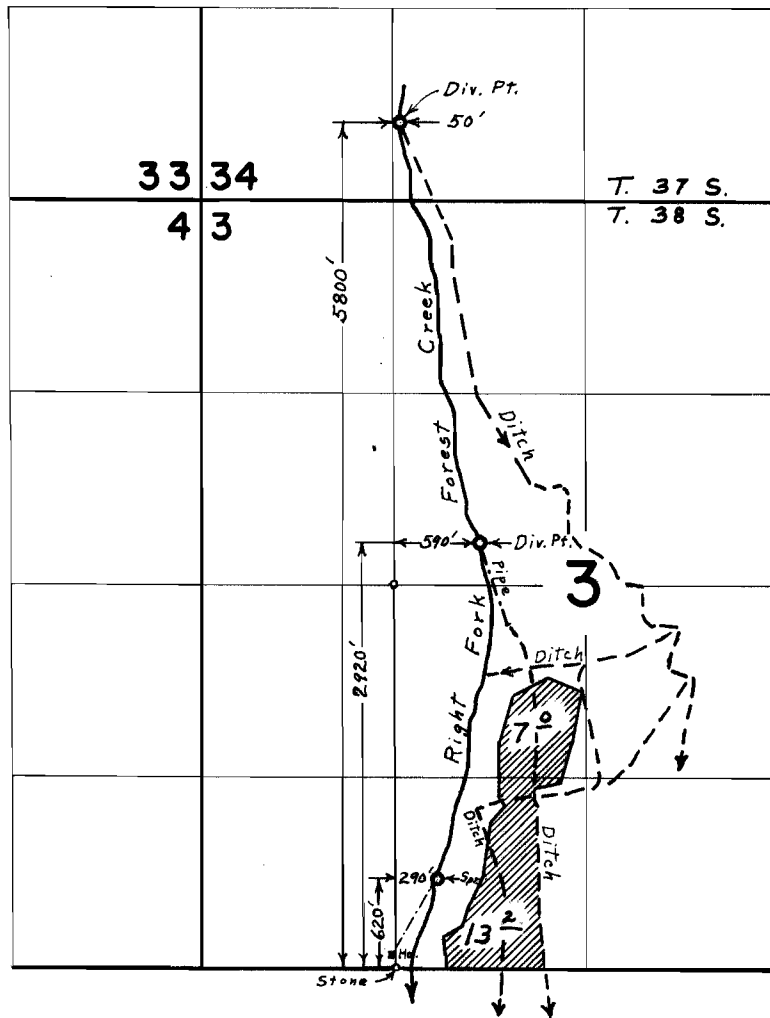

## FINAL PROOF SURVEY UNDER

Application No. 37591 Permit No. 28108  
IN NAME OF

**WAYNE A. MEEDS**

Surveyed July 28, 1967, by L. E. Gould