


T.39 S.R.2 W.W.M.

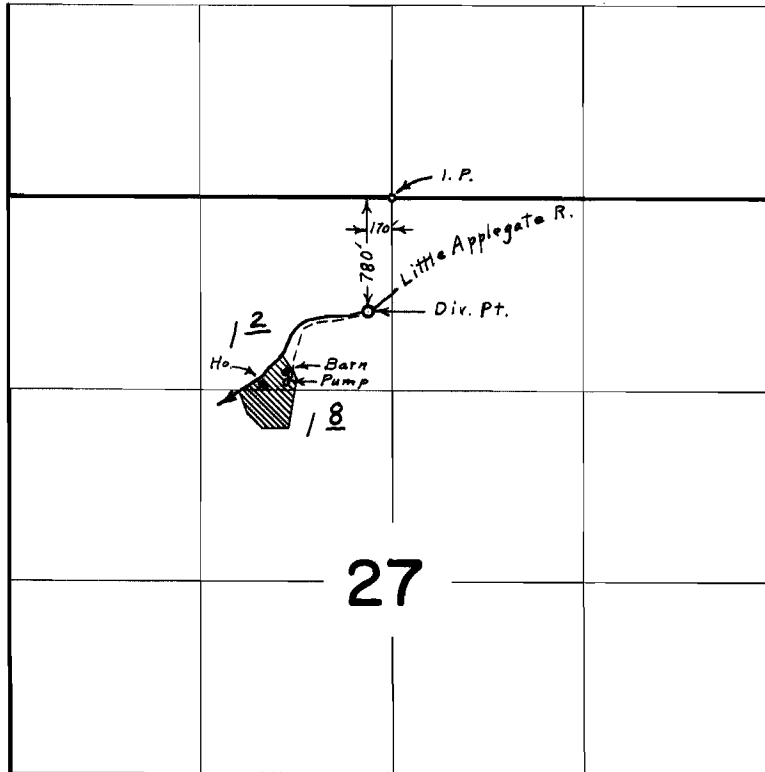

FINAL PROOF SURVEY UNDER

Application No. 38782 Permit No. 28851
IN NAME OF

J. LOWELL & CHARLOTTE C. MERRILL

Surveyed Aug. 3, 1967, by L. E. Gould