


T.34S.R.IW.W.M.

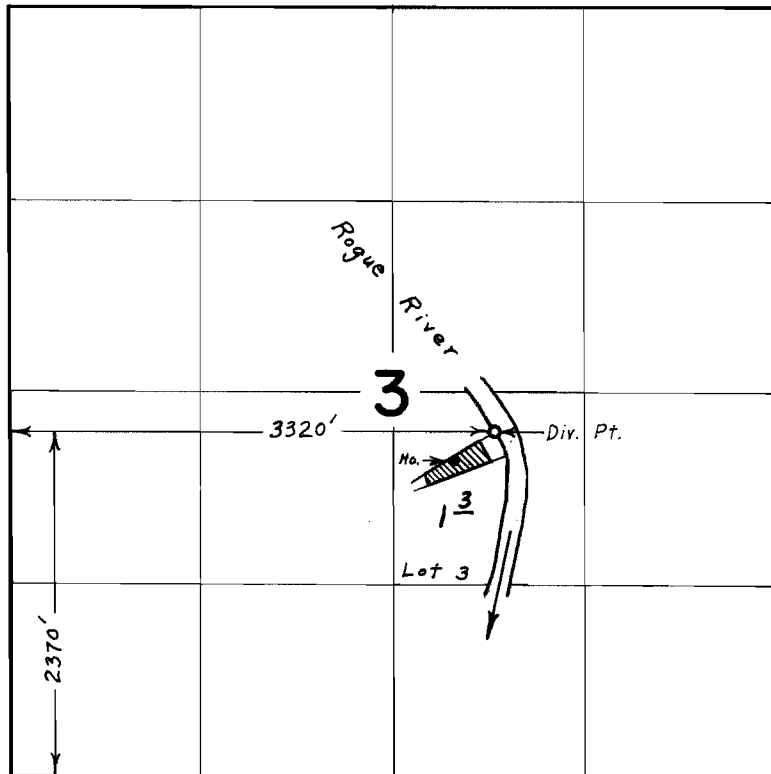

FINAL PROOF SURVEY UNDER

Application No. 39618 Permit No. 29439

IN NAME OF

EDMUND M. & HENRIETTA E. BERRY

Surveyed July 24, 1967. by L. E. Gould