


T.35 S.R.IW.W.M.

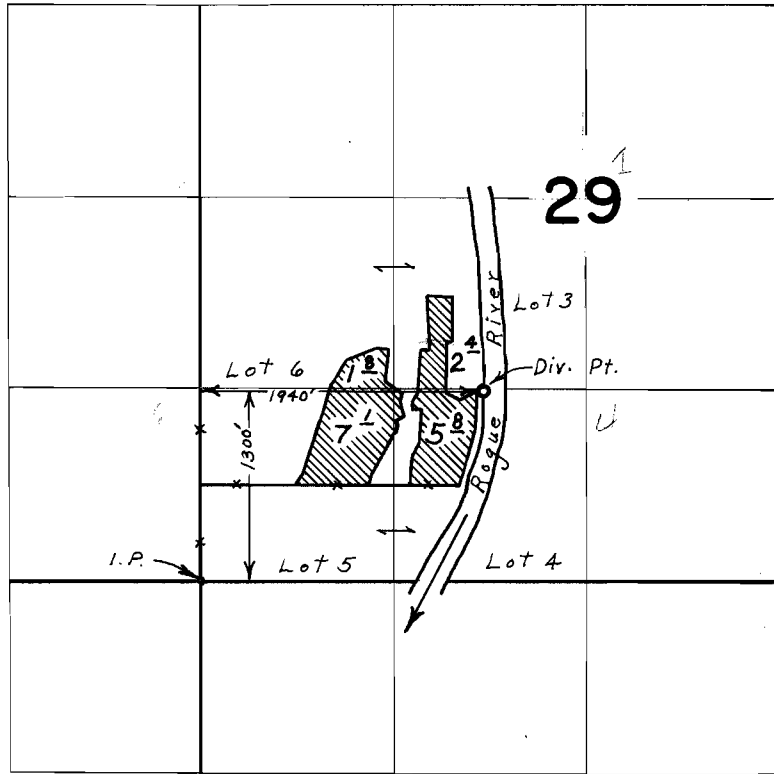

FINAL PROOF SURVEY
UNDER

Application No. 40303 Permit No. 30060
IN NAME OF

ROBERT S. GRIFFIN

Surveyed July 26, 1967, by L. E. Gould