


T.40S.R.3W.W.M.

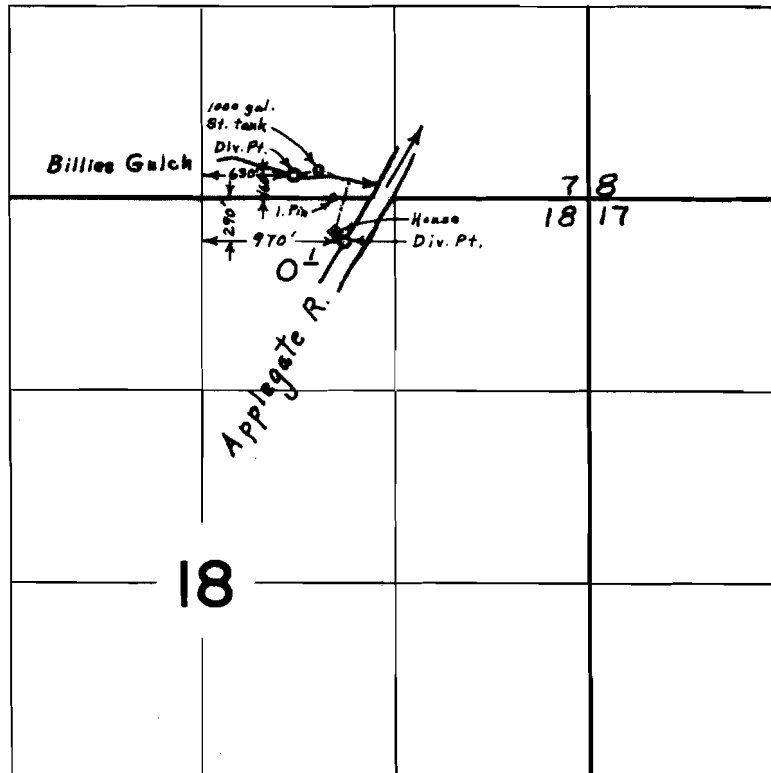

FINAL PROOF SURVEY
UNDER

Application No. 40856 Permit No. 30458
IN NAME OF
ART & LOIS GOSS

Surveyed Aug. 2, 1967, by L. E. Gould