


T.39S. R.5W. W. M.

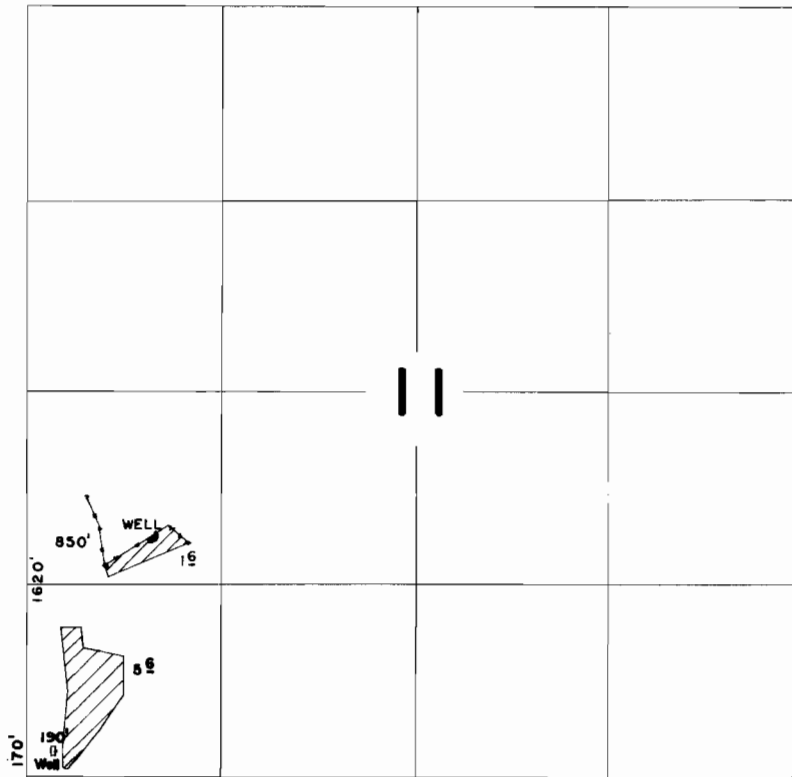

FINAL PROOF SURVEY UNDER

Application No. G-1790... Permit No. G-1711.....
IN NAME OF

.....AARON E. MORRISON.....

Surveyed ..MAY.15.. 1968., by ..R.B.STEIMER...