


T. 36 S. R. 5 & 6 W. W. M.

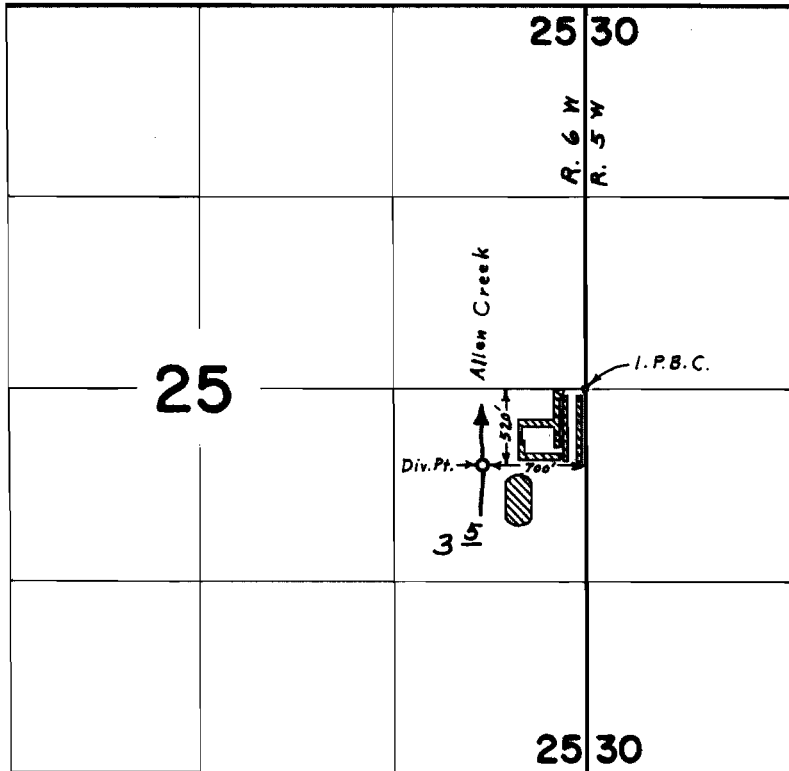

**FINAL PROOF SURVEY**  
UNDER

Application No. 42042 Permit No. 31471  
IN NAME OF  
**SCHOOL DISTRICT NO. 7**

Surveyed Aug. 29, 1967, by L. E. Gould