


T.36S.R.7W.W.M.

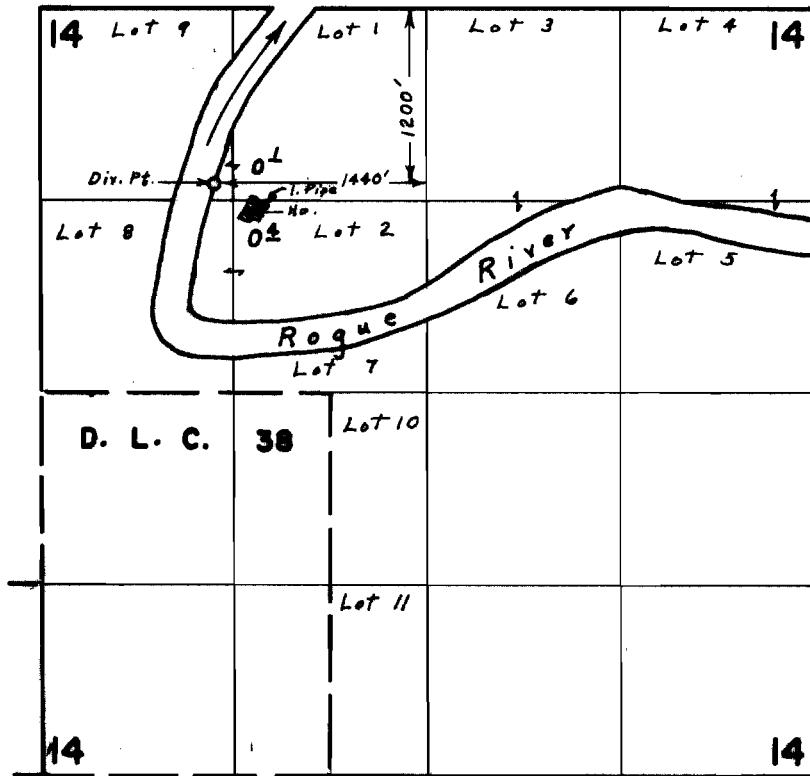

FINAL PROOF SURVEY
UNDER

Application No. 42792 Permit No. 31993
IN NAME OF
HAROLD G. BELL

Surveyed Aug. 30 1967, by L. E. Gen'd