


T.16S.R.4W.W.M.

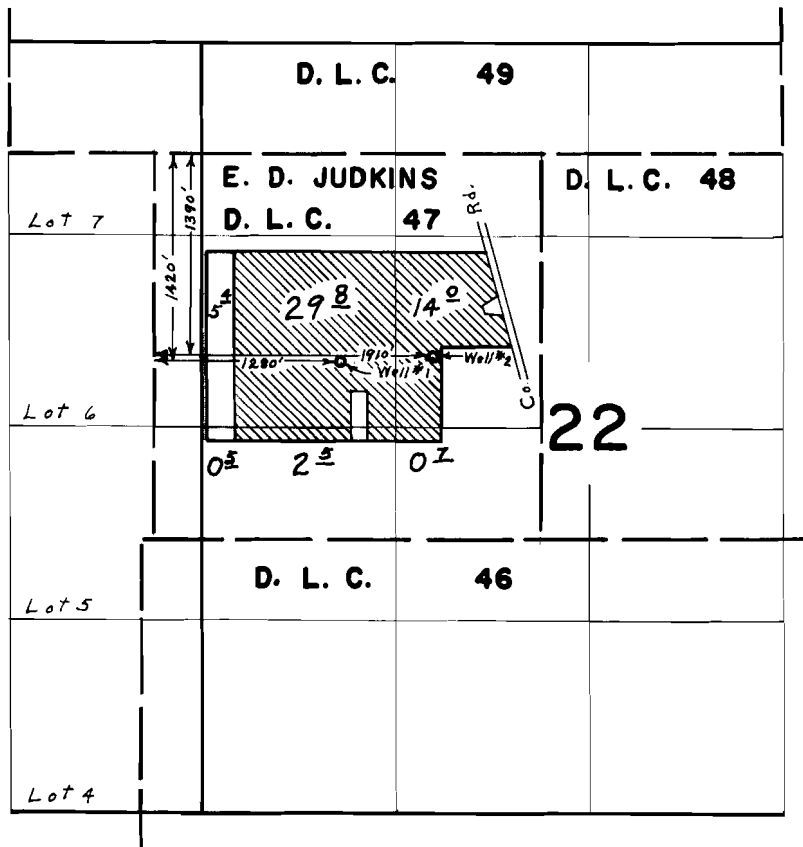

FINAL PROOF SURVEY UNDER

Application No. G-3018 Permit No. G-2808

IN NAME OF

MELVIN R. & JANET M. ANDREWS

Surveyed April 26, 1967, by L. E. Gould