


T. 20 S. R. 1 W. W. M.

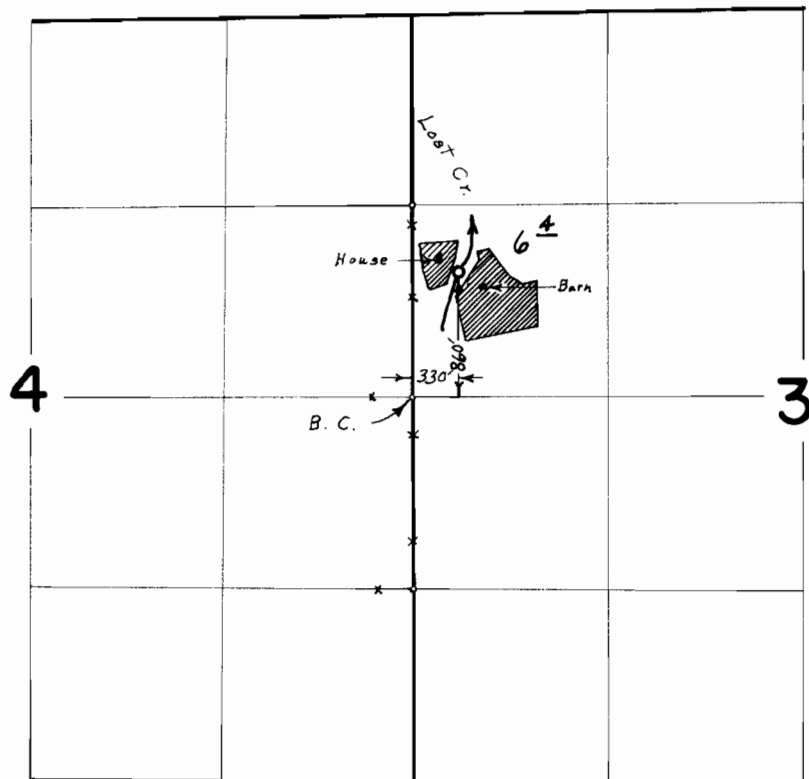

FINAL PROOF SURVEY
UNDER

Application No. 38761 Permit No. 28880
IN NAME OF

MAE BARNETT (MRS.)

Surveyed Sept. 18, 1967, by L. E. Gould