


T.9 S.R.11 W.W.M.

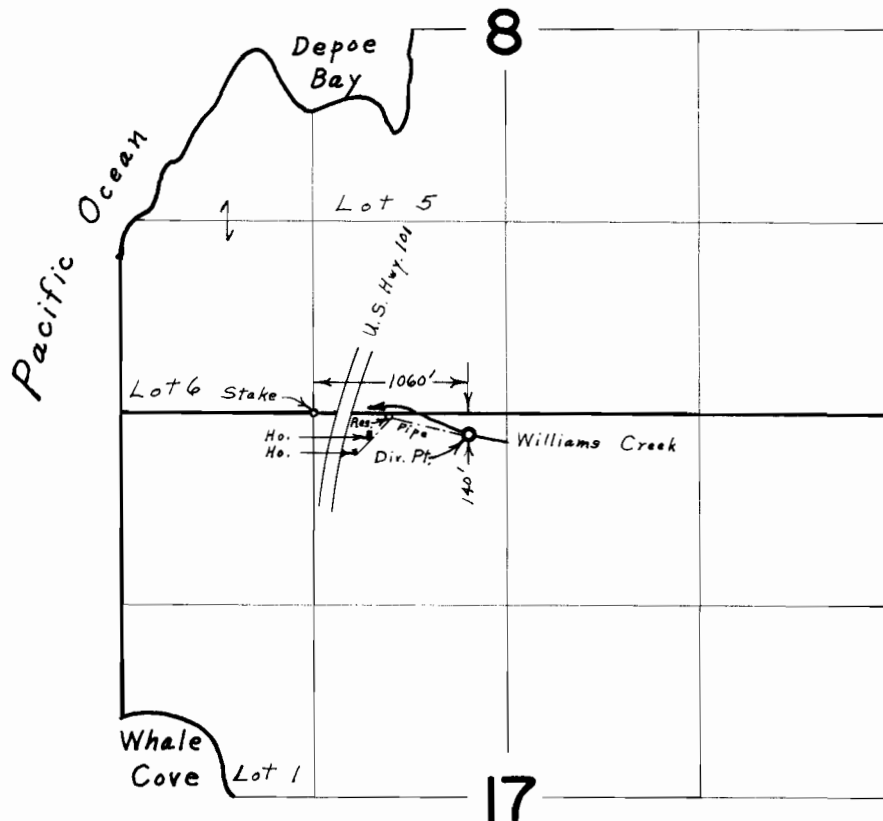

FINAL PROOF SURVEY
UNDER

Application No. 39331 Permit No. 29284
IN NAME OF

P. A. COURTNEY

Surveyed Sept. 26, 1967, by L. E. Gould