


T.I.O.S.R.II W.W.M.

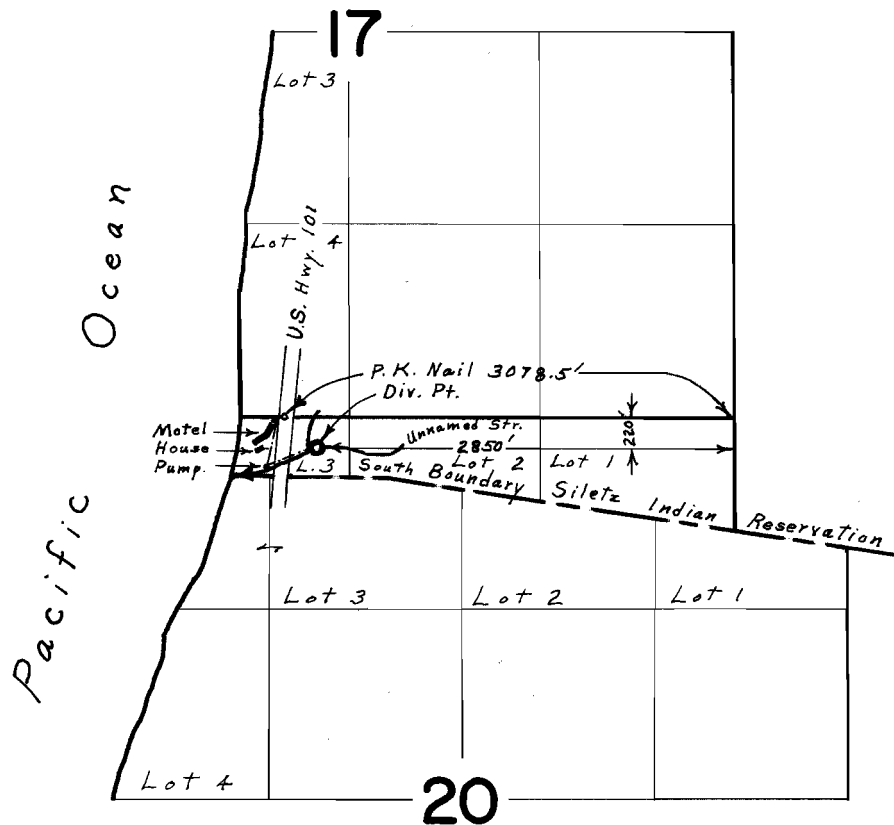

FINAL PROOF SURVEY

UNDER

Application No. 39871 Permit No. 29598
IN NAME OF

ROY & OLIVE PENCE

Surveyed Sept. 27, 1967, by L. E. Gould