


T.10 S.R.11 W.W.M.

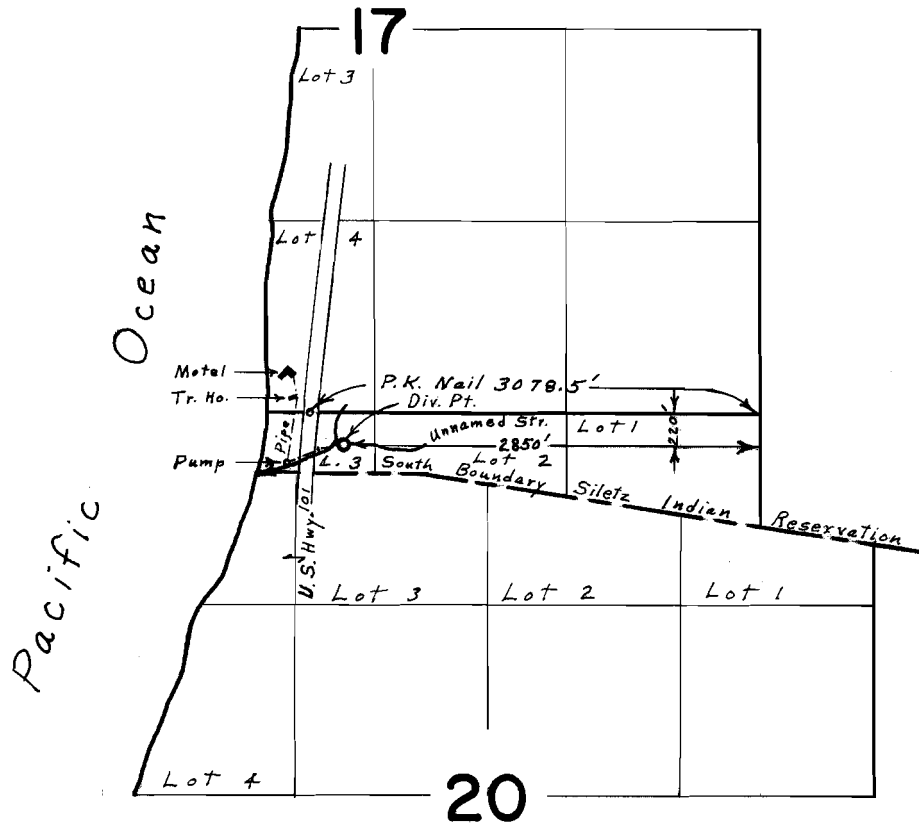

FINAL PROOF SURVEY UNDER

Application No. 40293 Permit No. 30052
IN NAME OF

GEORGE E. WEAVER

Surveyed Sept. 27, 1967, by L. E. Gould