


T.6 S.R.10W.W.M.

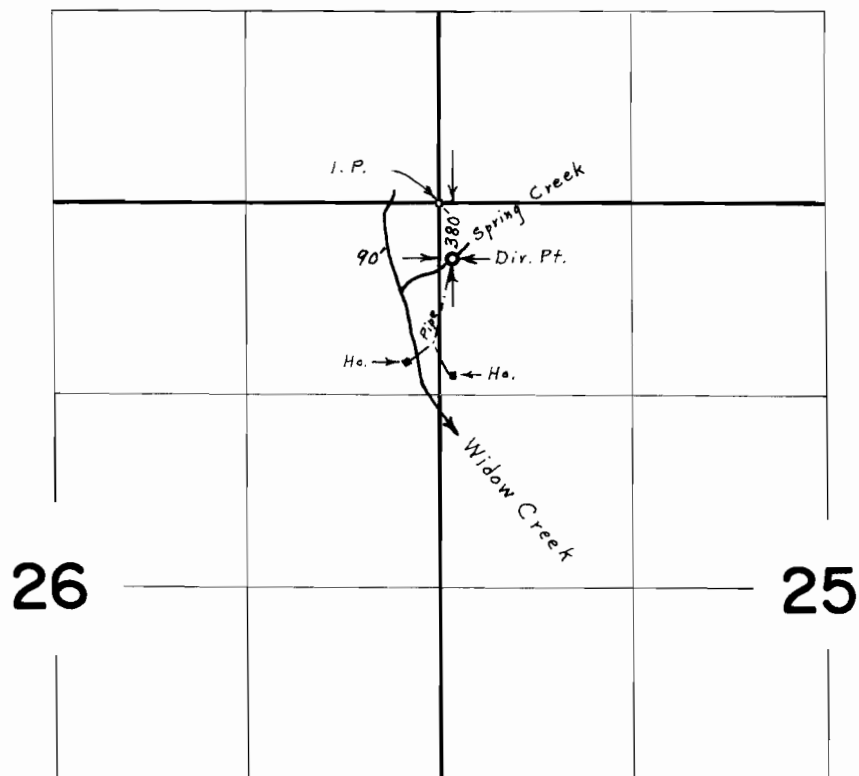

Note; pipe lines shown are approximate. location

FINAL PROOF SURVEY
UNDER

Application No. 41567 Permit No. 31008
IN NAME OF

REINHARDT & EMMA LIESMAN

Surveyed Aug. 15, 1967, by L. E. Gould