


T. 6 & 7 S. R. 10 W. W. M.

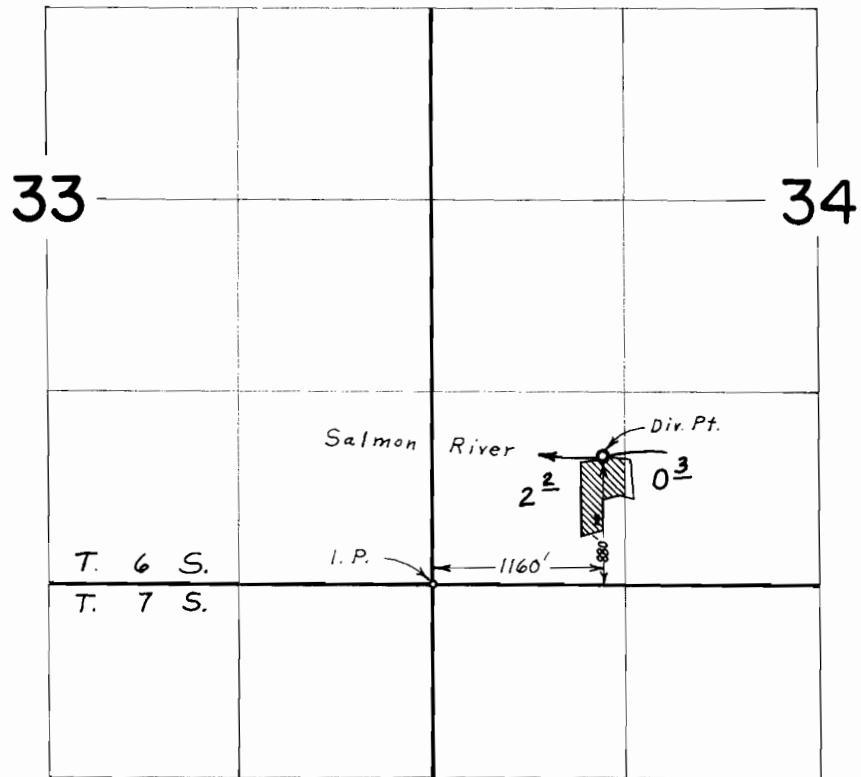

FINAL PROOF SURVEY UNDER

Application No. 42858 Permit No. 32031
IN NAME OF

C. A. RICKETTS

Surveyed Aug. 15, 1967, by L. E. Gould