


T.10S.R.2W.W.M.

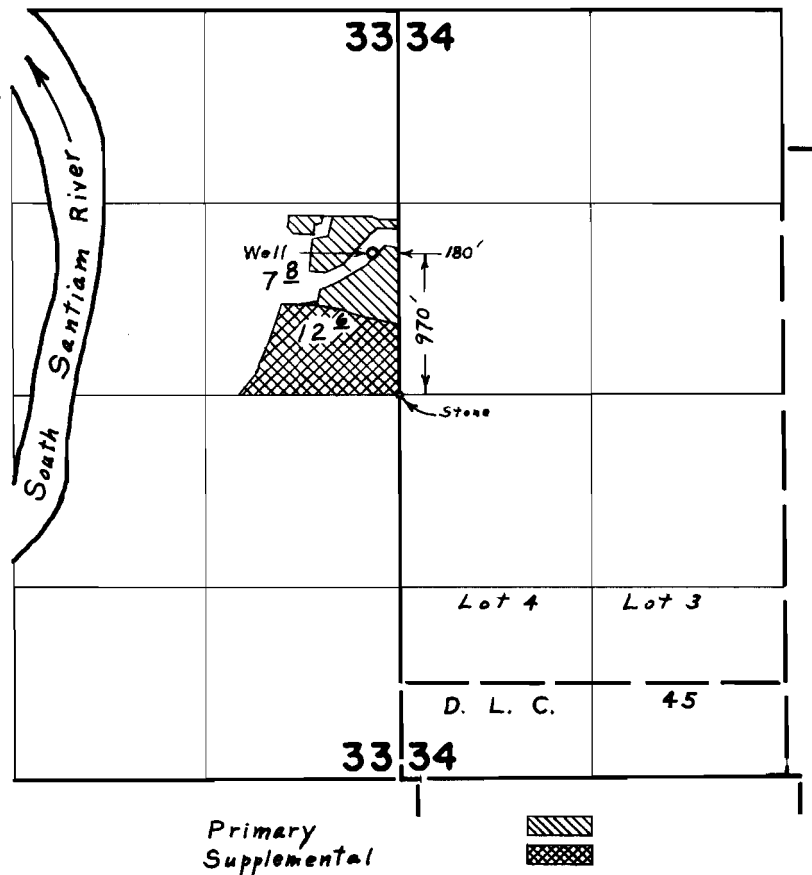

FINAL PROOF SURVEY UNDER

Application No. G-2351. Permit No. G-2171.
IN NAME OF

HAROLD A. BROWN

Surveyed Nov. 3, 1967, by L. E. Gould.