


FINAL PROOF SURVEY FOR RIVERVIEW DITCH ASSOCIATION T.10S.R.2W.W.M.

Application 27207 Permit 21524

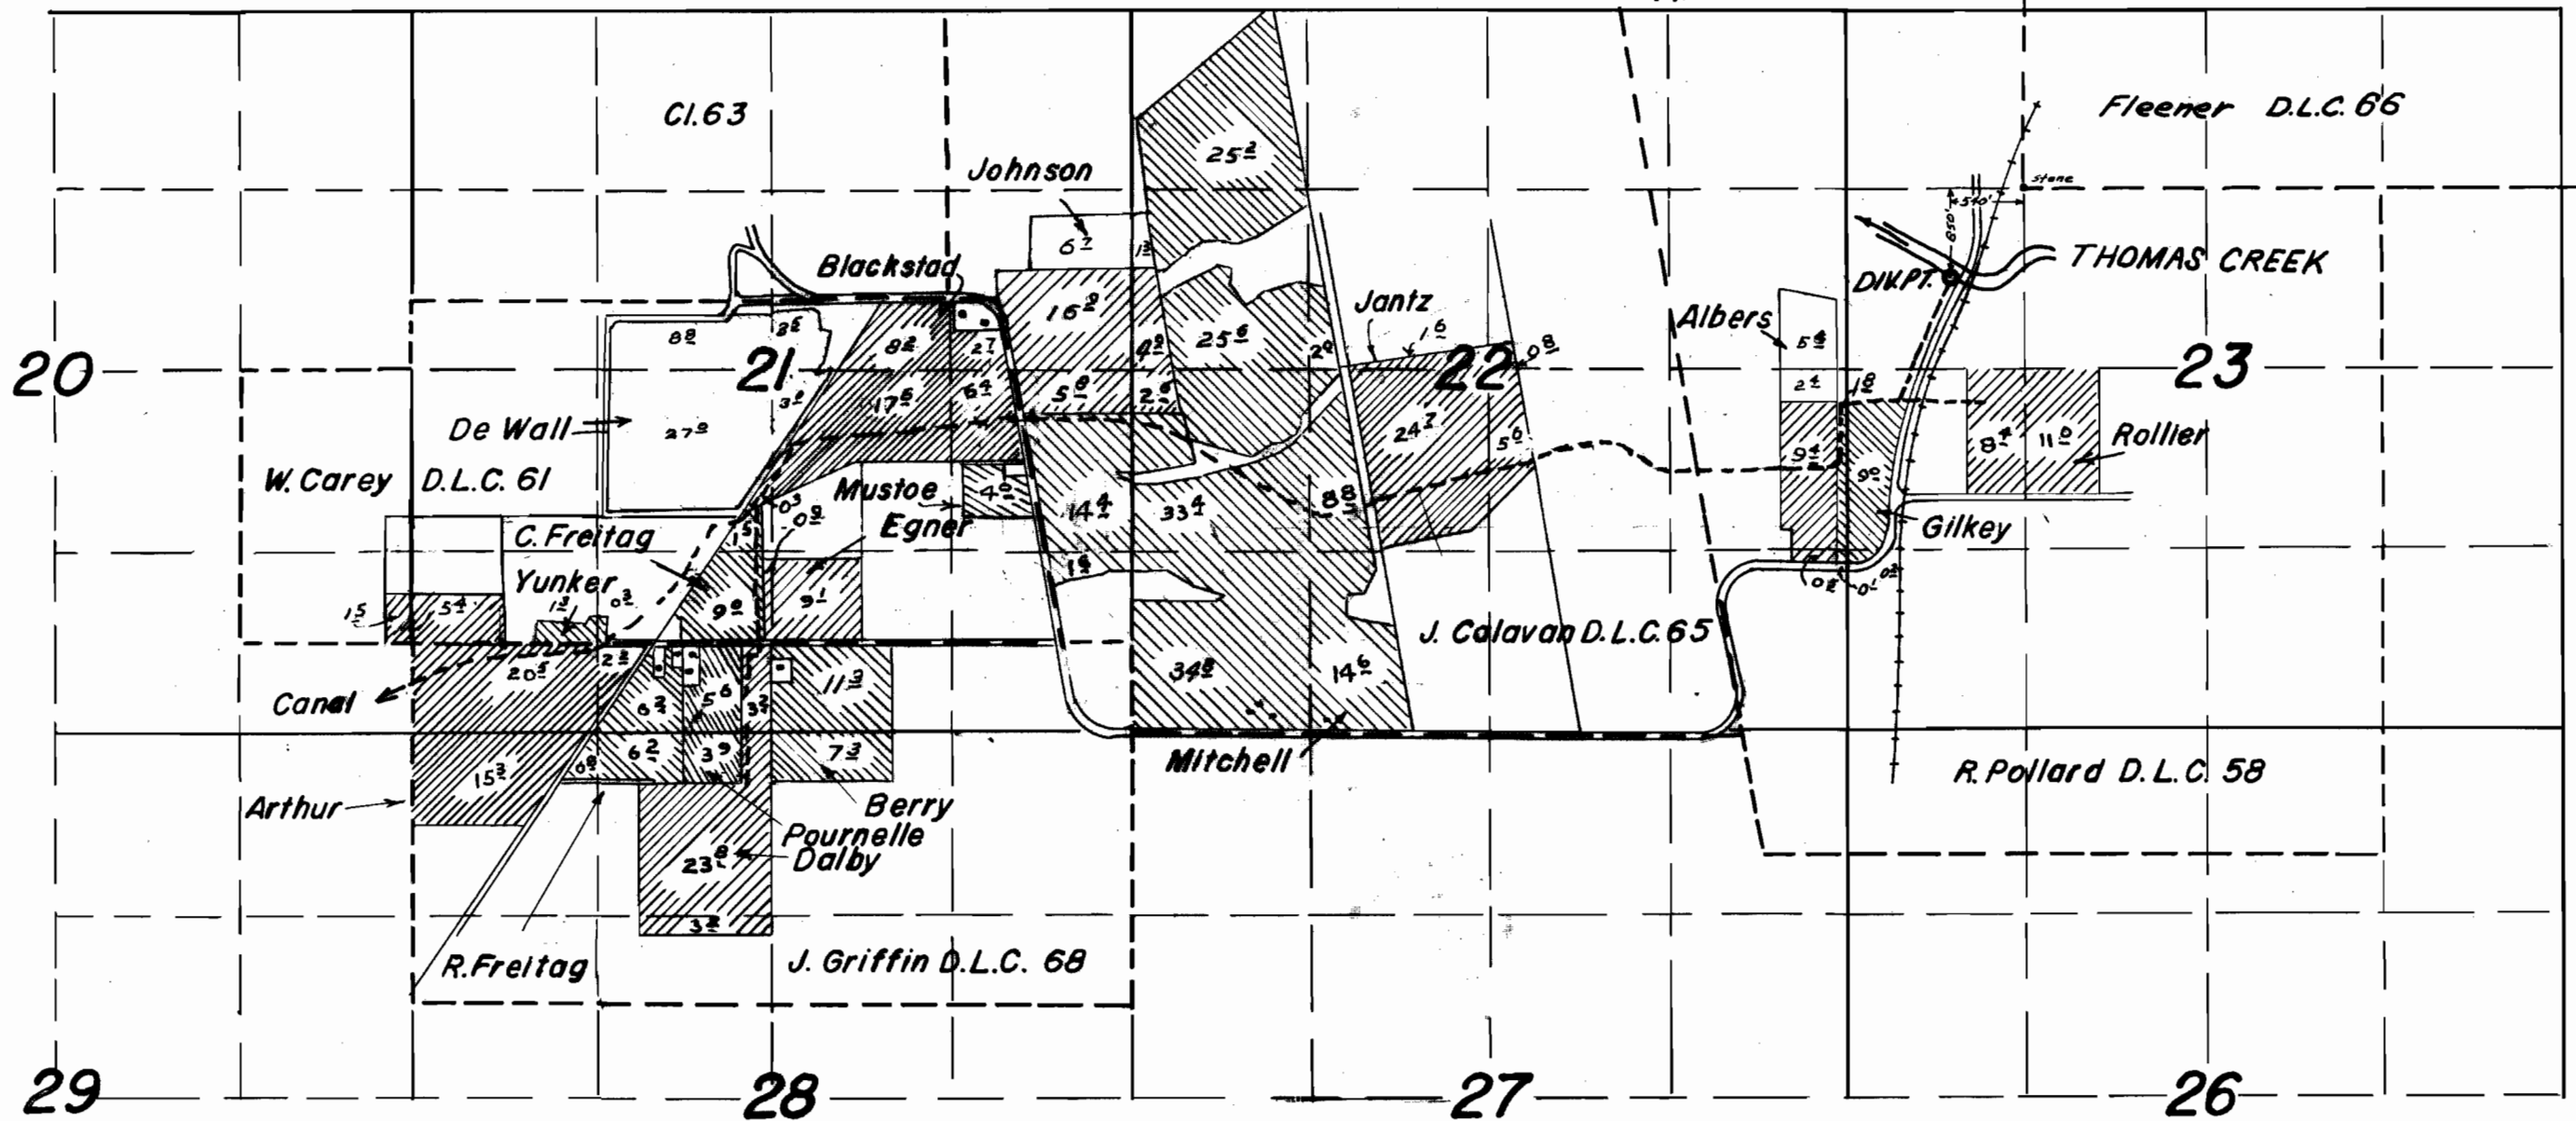

Surveyed May 10, 1965 by F.L. Siegmund