


T.14S.R.40&41E.W.M.

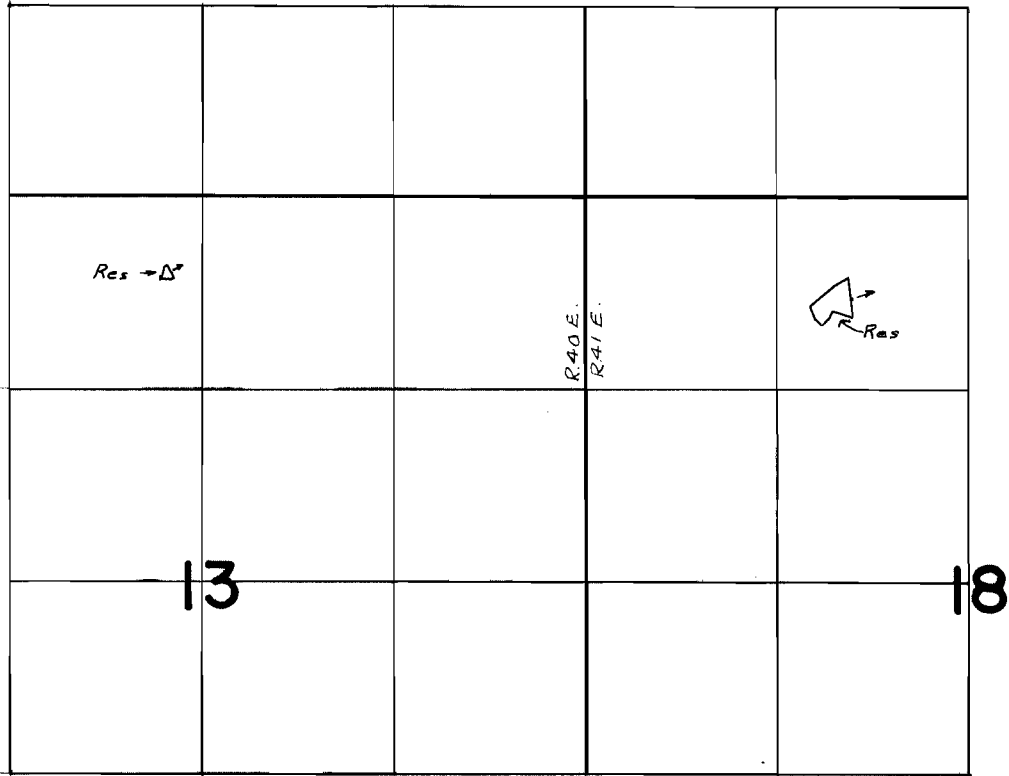

FINAL PROOF SURVEY UNDER

Application No. *R-38809* *R-38813* Permit No. *R-3681* *R-3685*
IN NAME OF

R. S. Langmack

Surveyed *Oct. 27* 19*67*, by *W. J. Ruppert*