

## T.14S.R.40&41E.W.M.

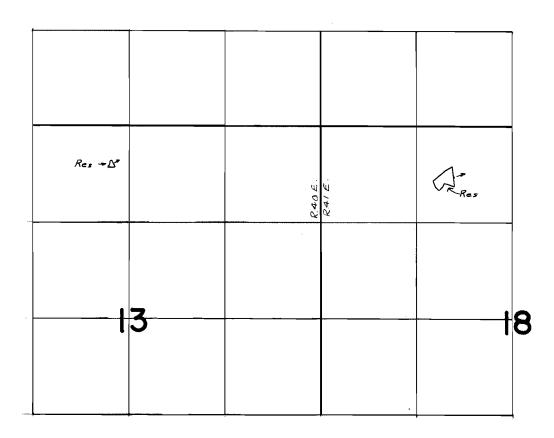

## FINAL PROOF SURVEY

R-38809 Application No. R-388/3. Permit N IN NAME OF	<i>R</i> -3681 <b>lo.</b> <i>R-3685</i>
R.S. Langman	.k
Surveyed Oct 27 19.67, by W.	I. Ruppert

## T.14S.R.40E.W.M.

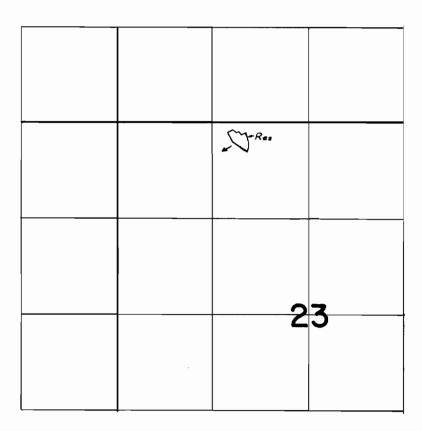

## FINAL PROOF SURVEY

Application No. R.38810. Permit No. R.3682. IN NAME OF	
R.S. Langmack	
Surveyed Oct. 30. 19.67, by W.J. Ruppact.	