


T.14S.R.40&41E.W.M.

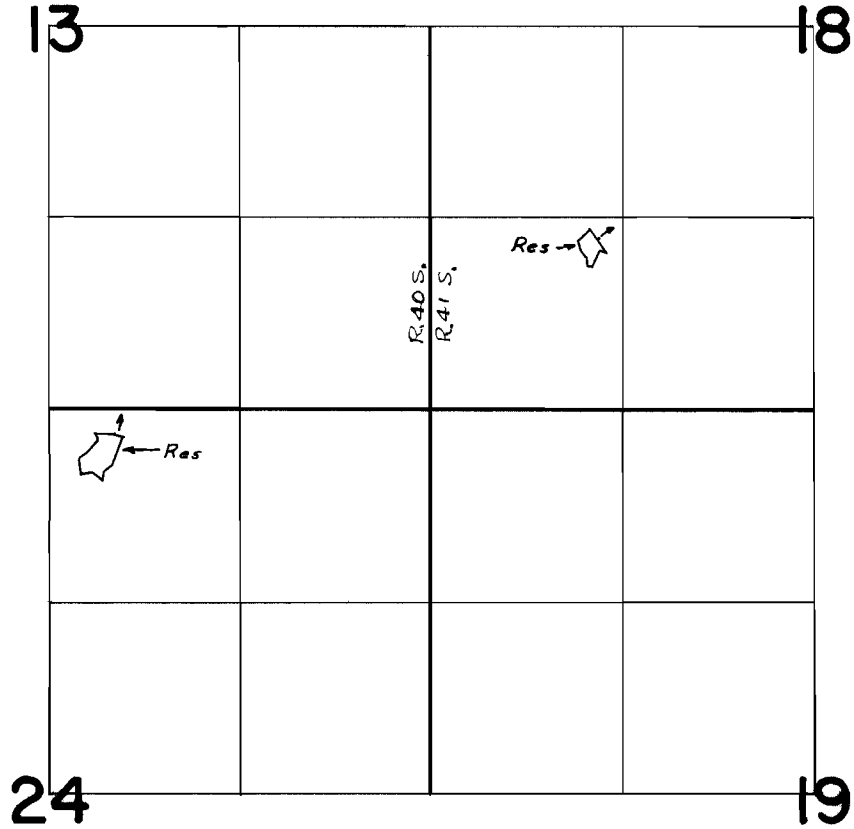


FINAL PROOF SURVEY
UNDER

Application No. *R-38811* Permit No. *R-3683*
R-38812 *R-3684*
IN NAME OF

.....*R. S. Langmack*.....

Surveyed *Oct. 30* 19*67*, by *W. J. Ruppert*.....

T.14S.R.40&41E.W.M.

<i>Res → Δ°</i>			<i>R.40 E. R.41 E.</i>	
13				18

FINAL PROOF SURVEY UNDER

Application No. *R-38809* *R-3681*
R-38813 Permit No. *R-3685*
IN NAME OF

R. S. Langmack

Surveyed *Oct. 27* 19*67*, by *W. J. Ruppert*