


T.14S.R.40&41E.W.M.

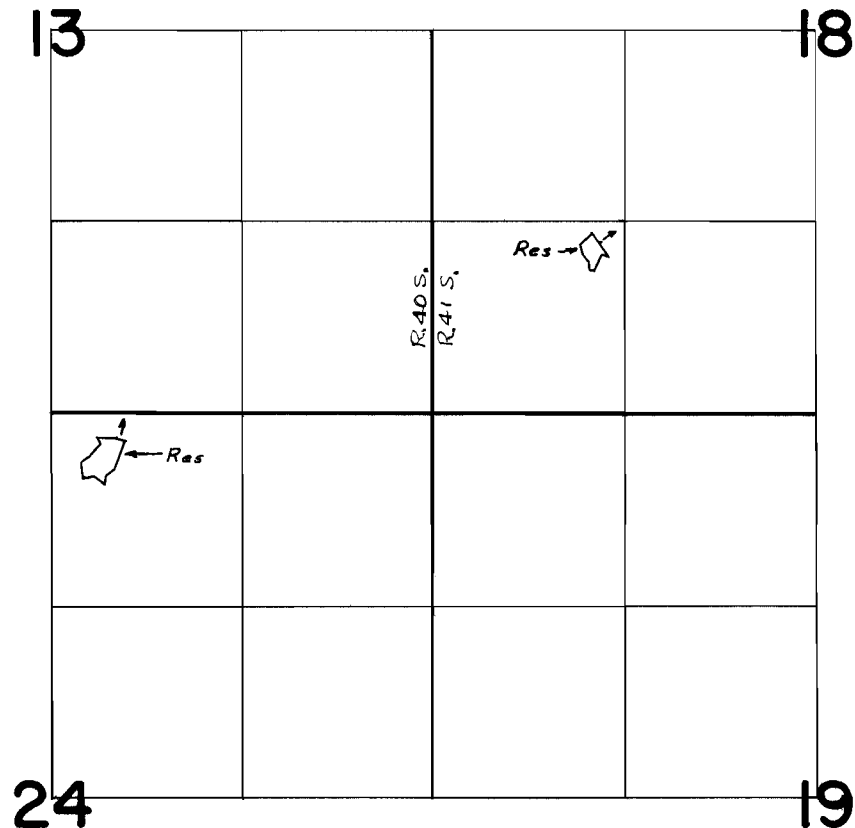

FINAL PROOF SURVEY
UNDER

Application No. R-38811 Permit No. R-3683
R-38812 R-3684
IN NAME OF

R. S. Langmack

Surveyed Oct 30 1967, by W. J. Ruppert

T.14S.R.40&41E.W.M.

<i>Res → Δ</i>			<i>R40E. R41E.</i>	
13				18

FINAL PROOF SURVEY
UNDER

Application No. *R-38809* Permit No. *R-3681*
R-38813 *R-3685*
IN NAME OF

R. S. Langmack

Surveyed *Oct. 27* 19*67*, by *W. J. Ruppert*