


Per. 3780

3549

10 South
28 East or m.

North
160 yds.
from
the
road

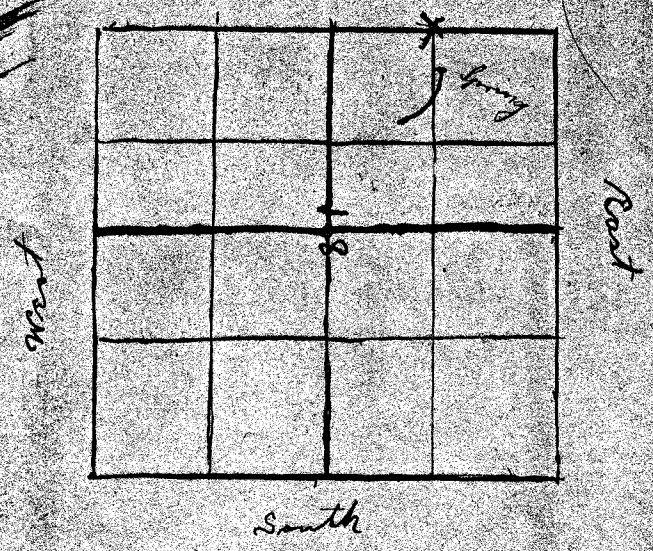

Application No.
Permit No.

6058
3780

OFFICE OF STATE ENGINEER

RECEIVED

APR 8 1918

SALEM, OREGON