


T.19S.R.43E.W.M.

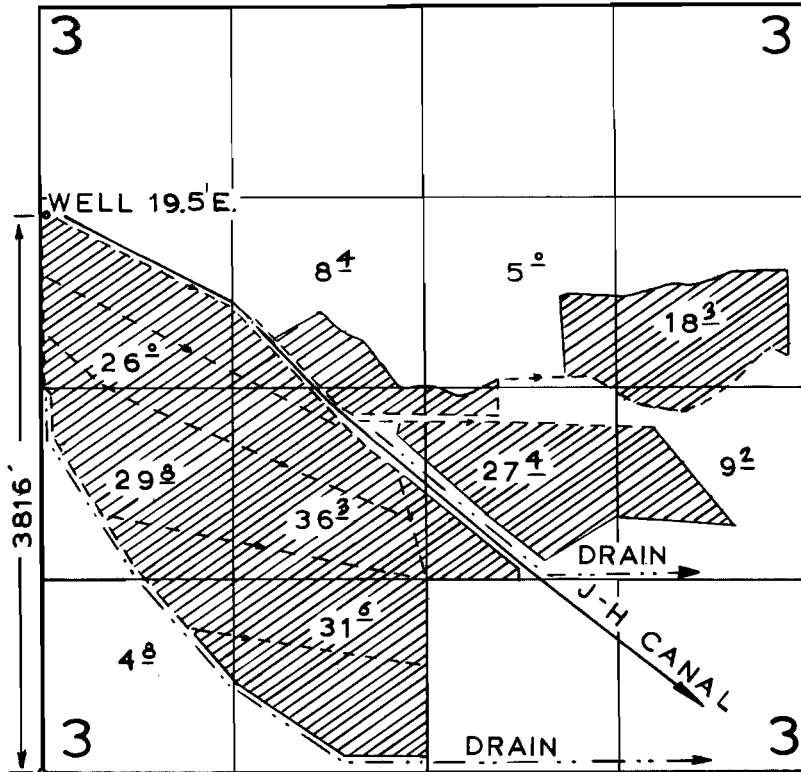

**FINAL PROOF SURVEY**  
UNDER

Application No. G- 2115... Permit No. G-1938...  
IN NAME OF

FLOYD VAUGHAN

Surveyed NOV. 8 1967, by F.ELFERING...