


T.8 S. R.1 W. W.M.

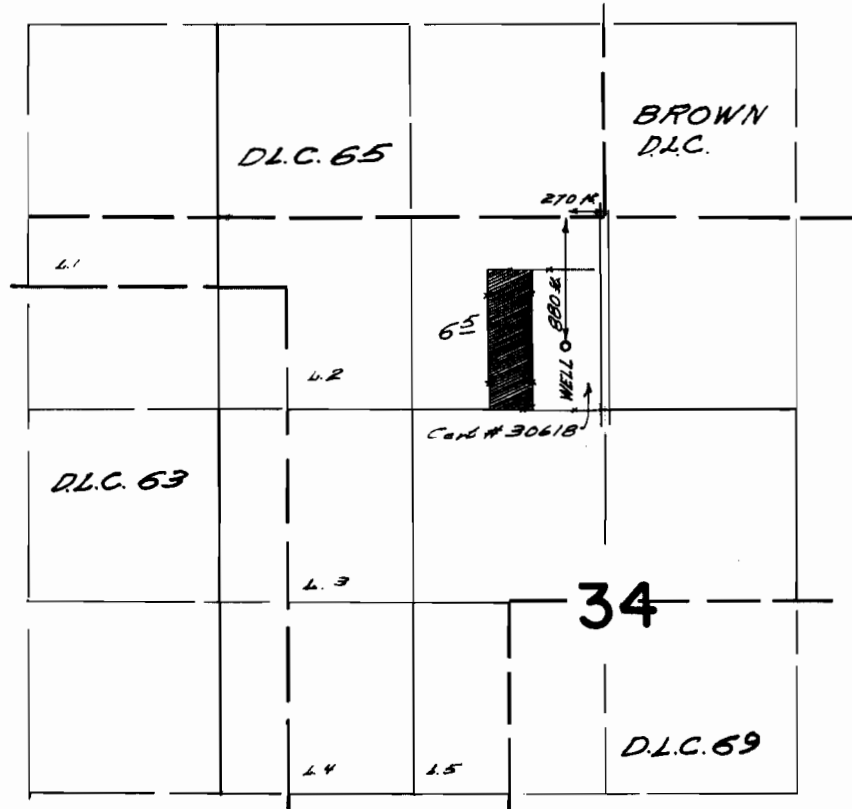

FINAL PROOF SURVEY
UNDER

Application No. *G-2691* Permit No. *G-2496*
IN NAME OF

Robert M. Stukart

Surveyed *Sept. 19 1967*, by *W. d. Ruppert*.