


T 4 S. R. 2 W. W. M

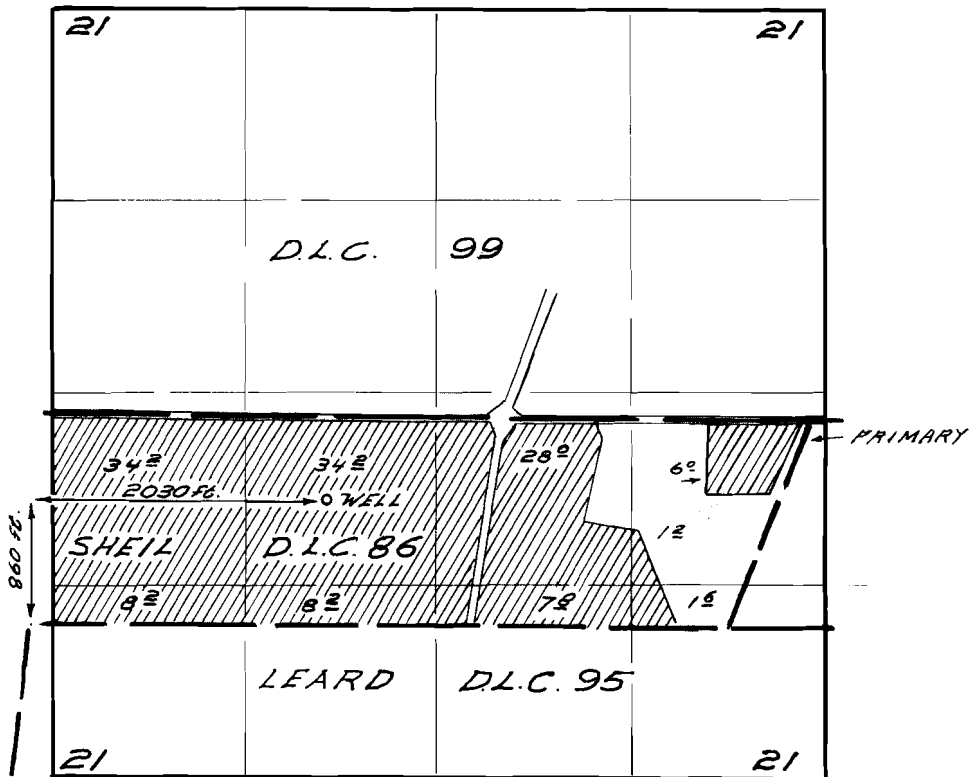

FINAL PROOF SURVEY UNDER

Application No. G-2791 Permit No. G-2601
IN NAME OF

RALPH A. CASE

Surveyed 4-11 1967, by W. J. Ruppert
5-14-67