


# T. 4 S. R. 2 W. W. M.

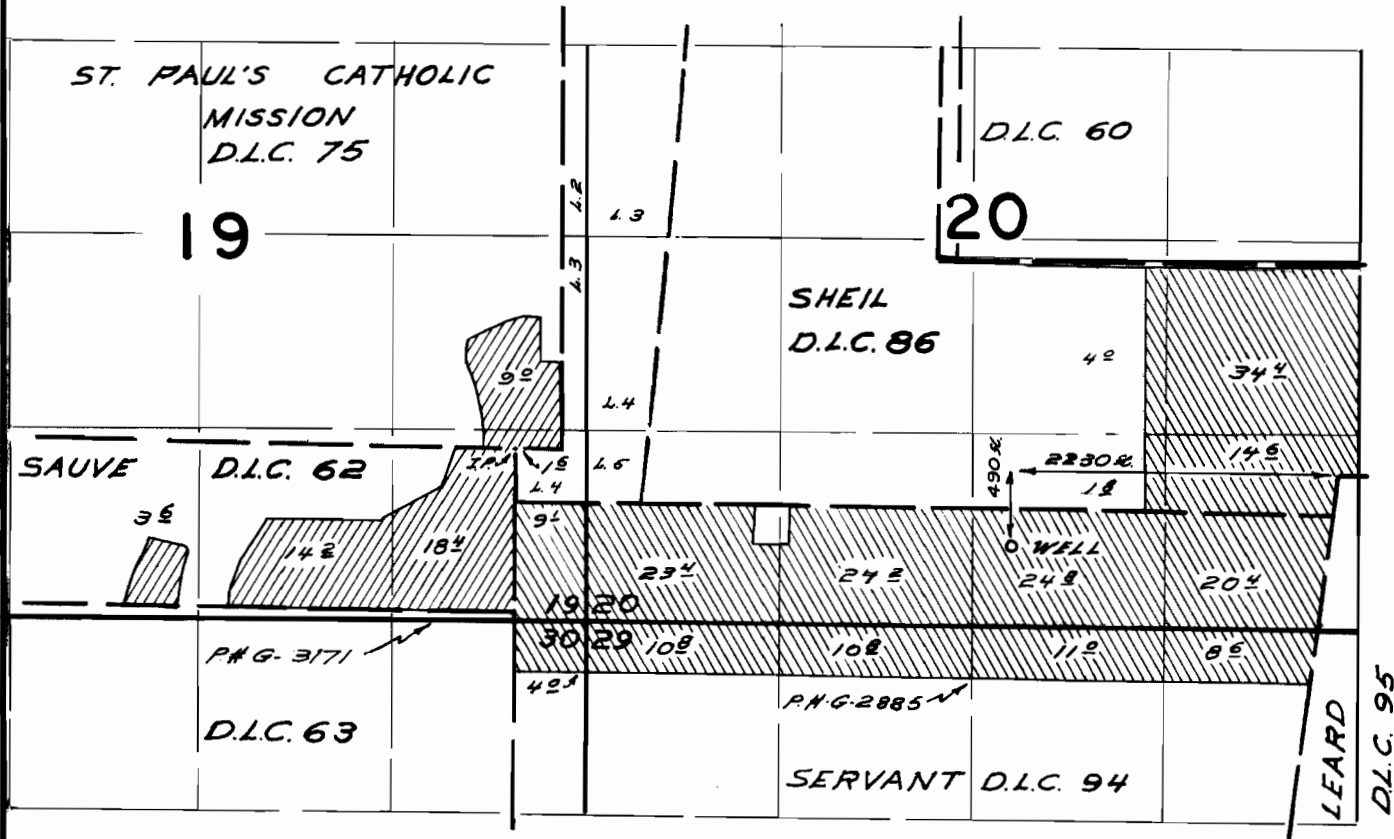

## FINAL PROOF SURVEY UNDER

Application No. G-3088 Permit No. G-2885  
G-3365 Permit No. G-3171  
 IN NAME OF

EDWARD T. BRENTANO

Surveyed April 11 & 12 1967, by W.D. Ruppert