T. 4 S. R. 2 W. W. M.

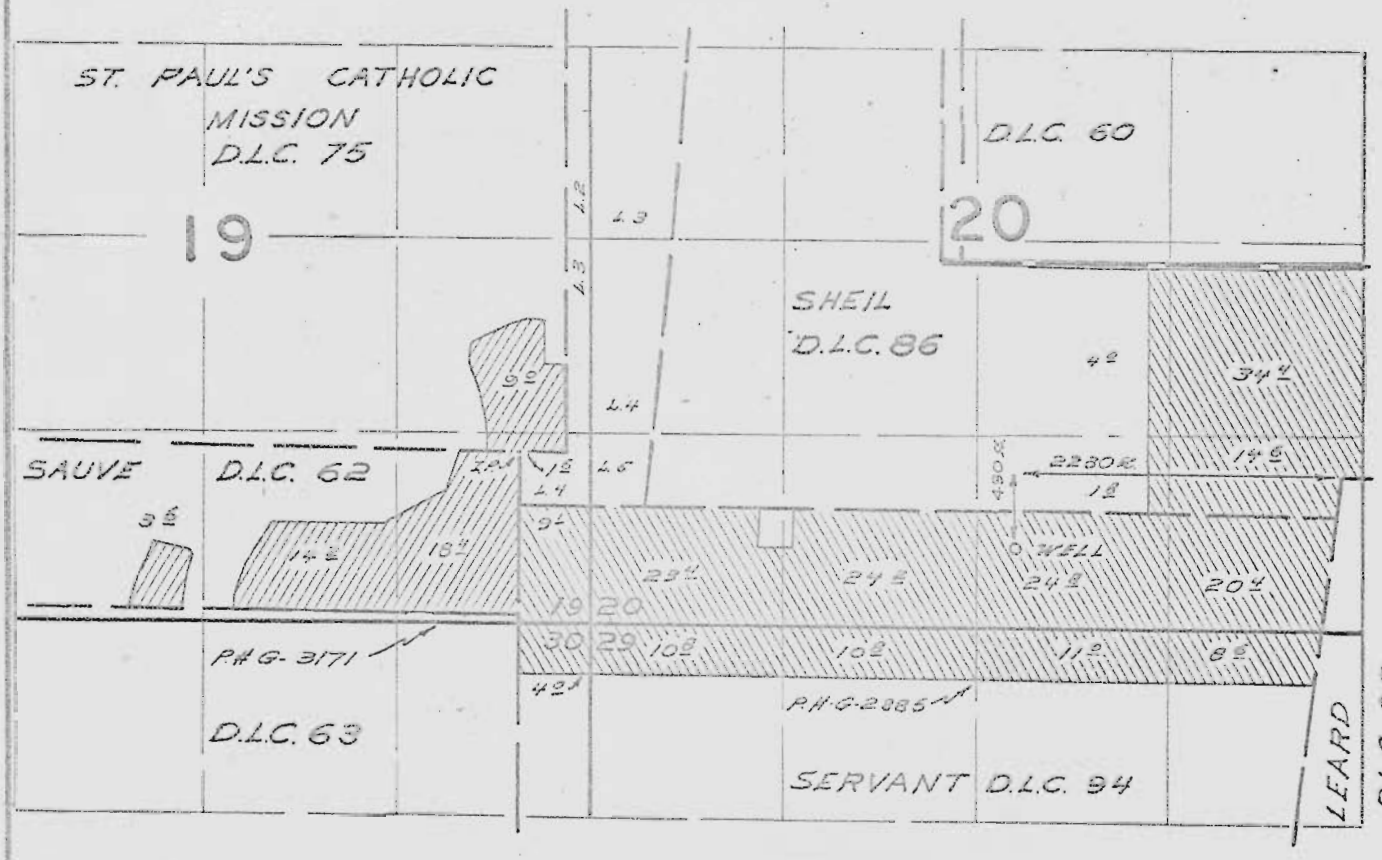

FINAL PROOF SURVEY

UNDER

G-3088 G-2885

Application No. G-3365 Permit No. G-3171

IN NAME OF

EDWARD T. BRENTANO

Surveyed April 11 & 12 1967, by W. U. Ruppert.

1967-K