


T. 4 S. R. 2 W. W. M.

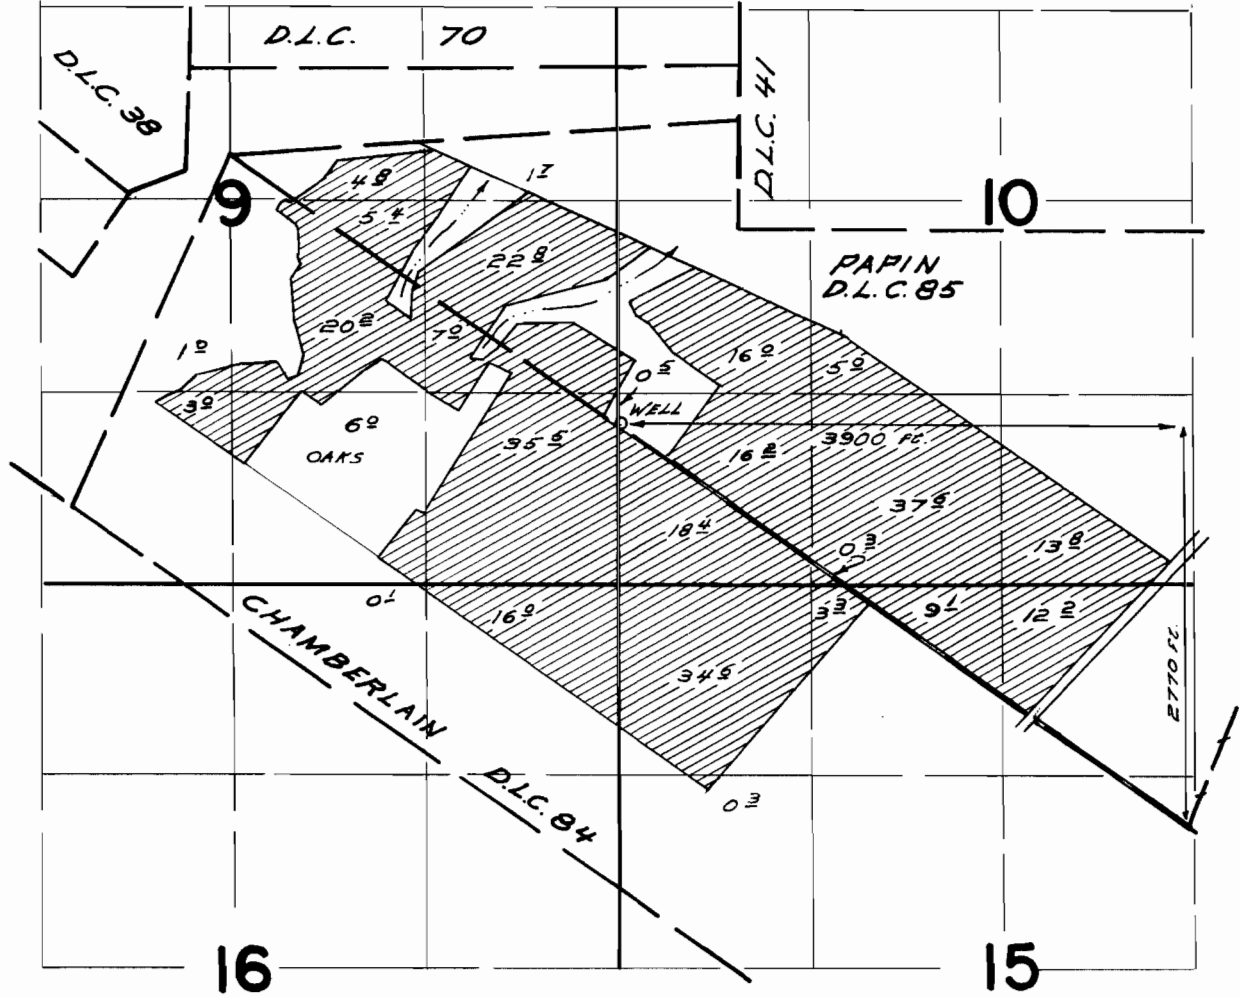

FINAL PROOF SURVEY
UNDER

Application No. *G-3406* Permit No. *G-3195*
IN NAME OF

DON'S INC.

Surveyed *April 11, 1967*, by *N. J. Ruppert*