


T. 4 S. R. 1 W. W. M.

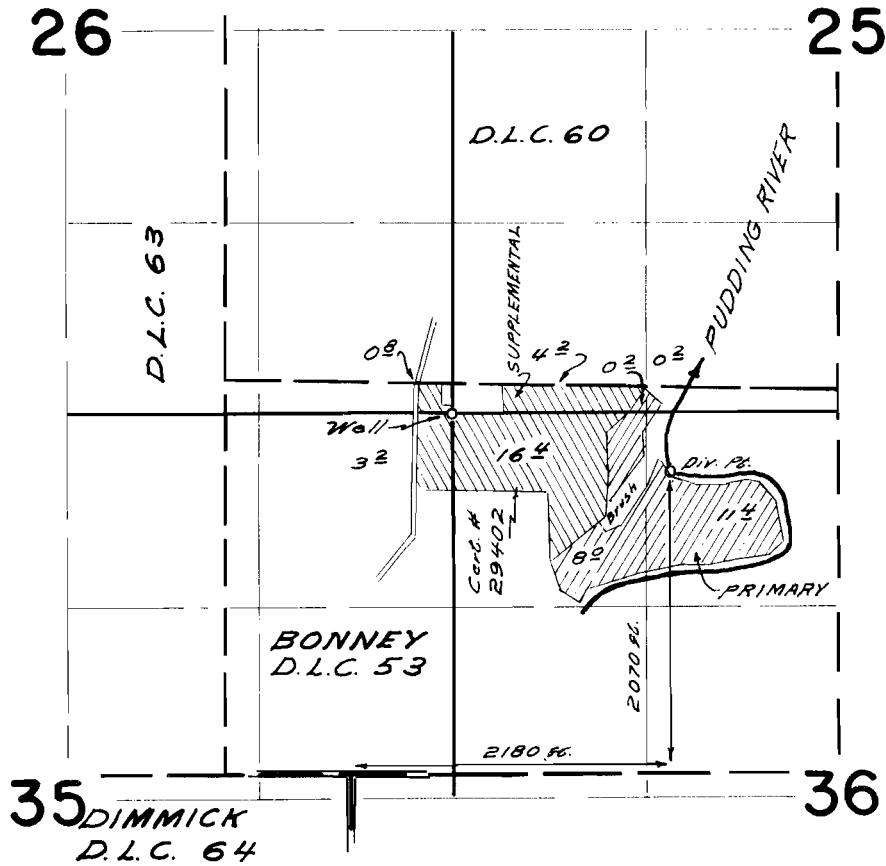

FINAL PROOF SURVEY
UNDER

Application No. 37668 Permit No. 28076
IN NAME OF

Lloyd H. & Jean M. Paradis

Surveyed May 5, 1967, by *Wd. Ruppert*