


# T.9S.R.IE.W.M.

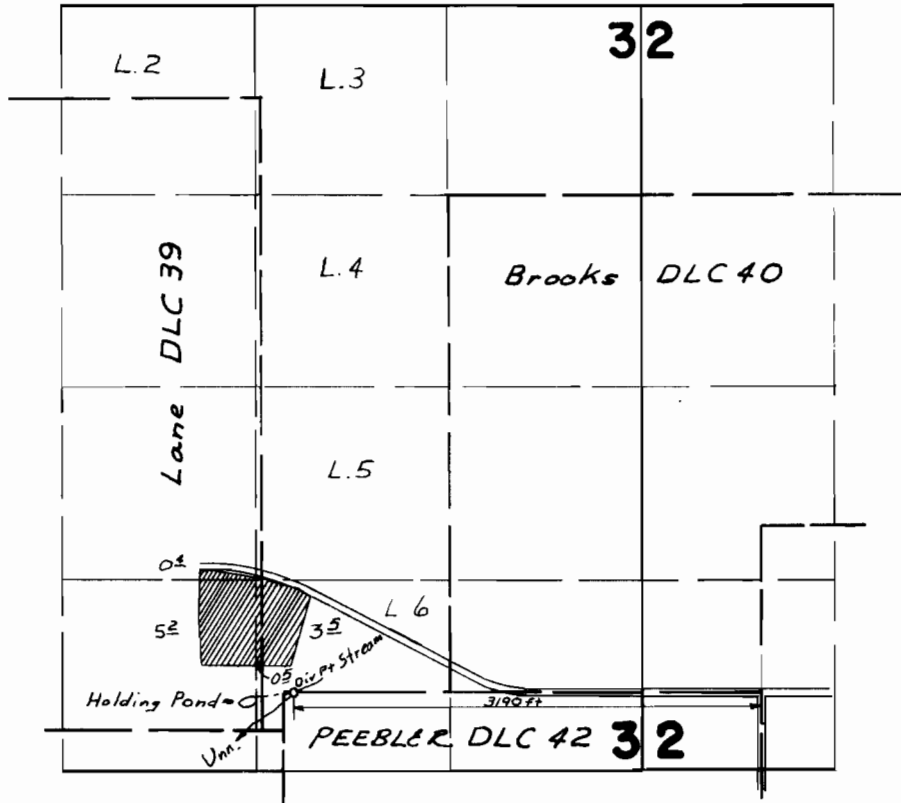

## FINAL PROOF SURVEY UNDER

Application No. 39034 Permit No. 29071  
IN NAME OF

*Joe Schmitz*

Surveyed Aug. 9, 1967, by *W. J. Ruppert*