


T. 4 S. R. 1 W. W. M.

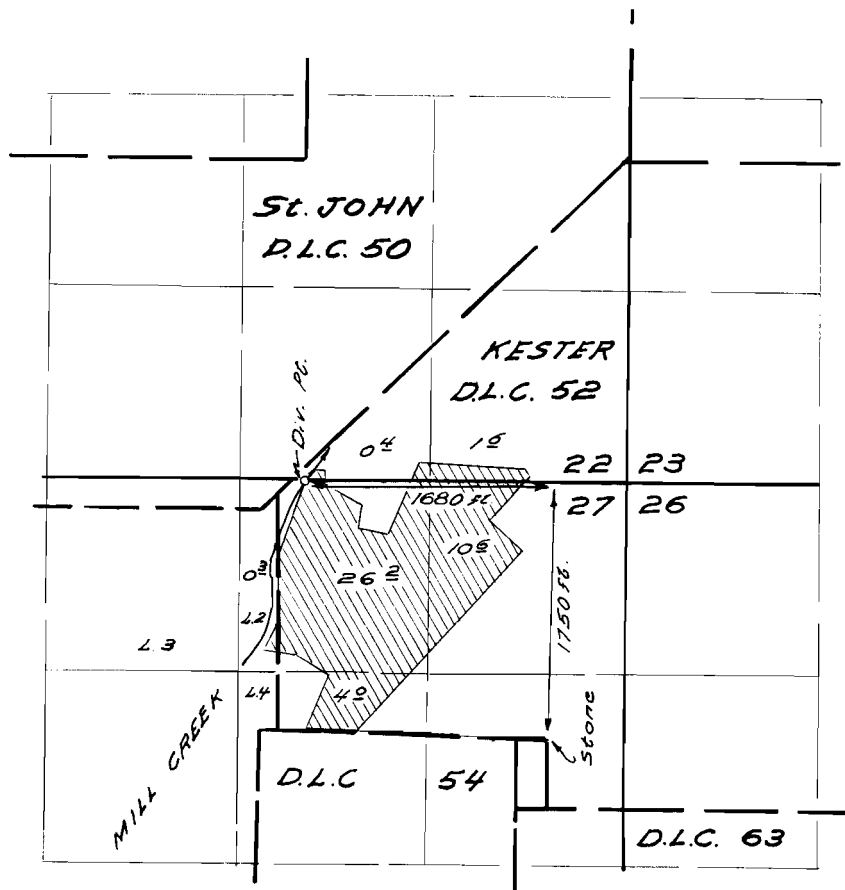

FINAL PROOF SURVEY UNDER

Application No. 39589 Permit No. 29422
IN NAME OF

John H. Bisanz

Surveyed May 5, 1967, by W. J. Ruppert