


# T.9S.R.2E.W.M.

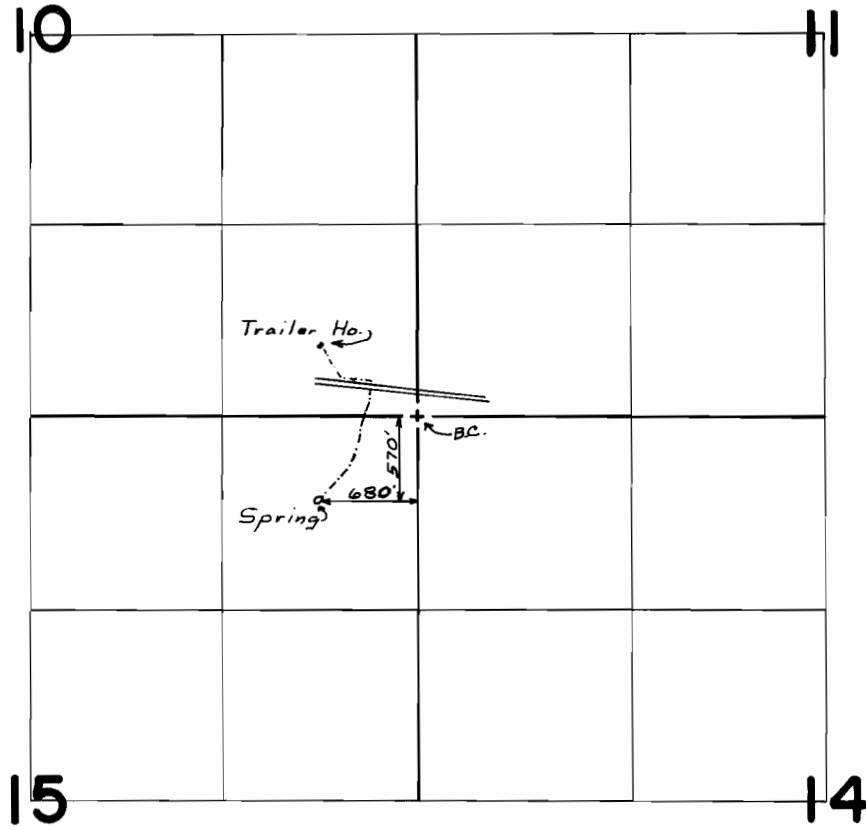

## FINAL PROOF SURVEY UNDER

Application No. 42828 Permit No. 32010  
IN NAME OF

Vincent L. Milligan

Surveyed Aug 9 1967, by W.J. Ruppert