


T.38&4 N. R.34 E. W.M.

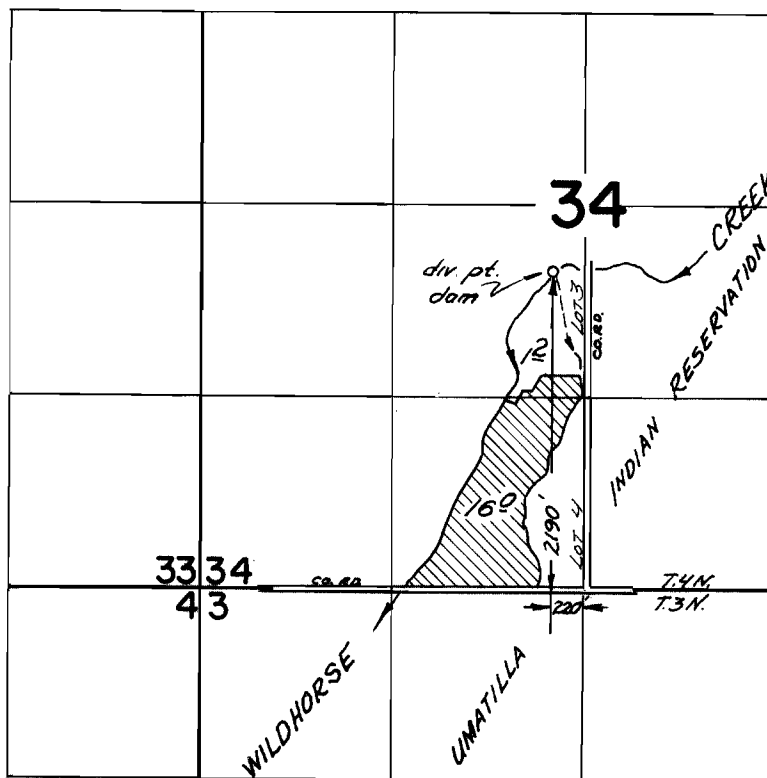

FINAL PROOF SURVEY
UNDER

Application No. 39/99 Permit No. 29148
IN NAME OF

FLOYD PAYNE

Surveyed Oct. 31, 1966, by V. Garner