


T.2N.R.14E.W.M.

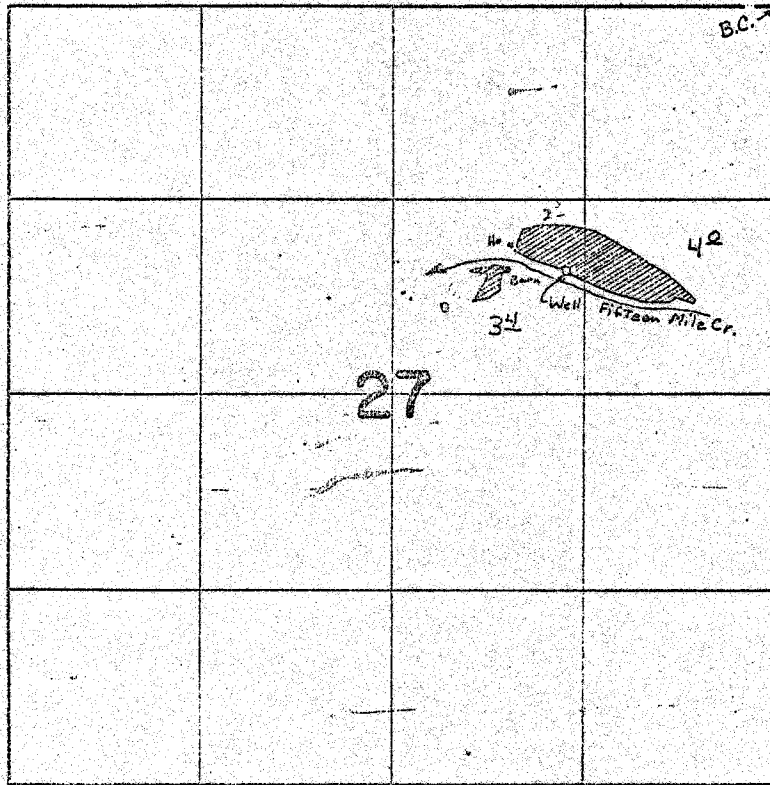

Div Pt located 1780 Ft S & 1450ft E from NE Cor Sec 27

**FINAL PROOF SURVEY**  
UNDER

Application No. G-2941. Permit No. G-2736  
IN NAME OF

*Carl W., Julius F., Evelyn M. Kasar*

Surveyed June 13, 1967, by *W. J. Ruppert*.