


R-3288

T.2S.R.12 E.W.M.

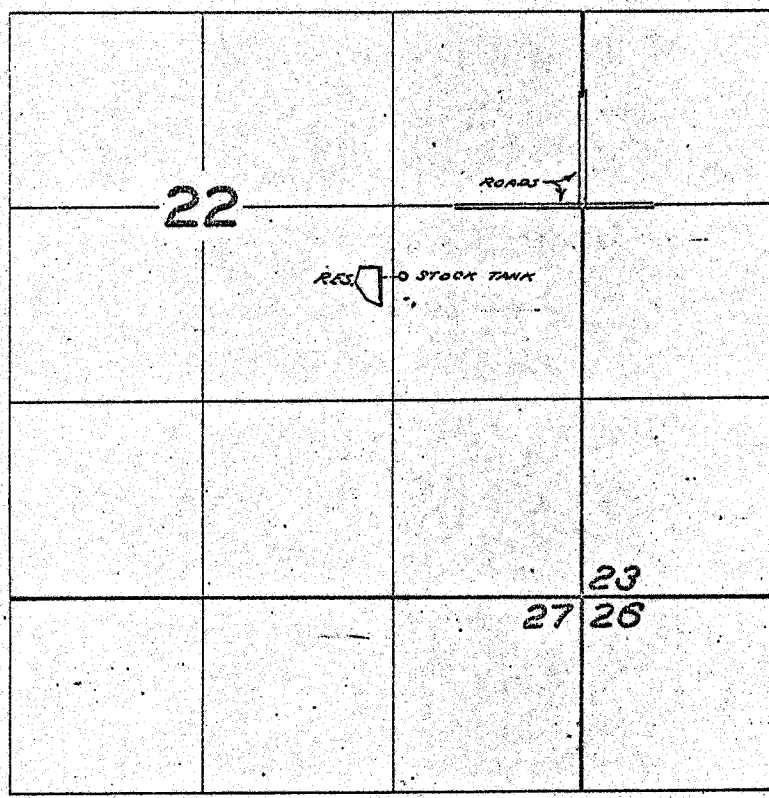

FINAL PROOF SURVEY UNDER

Application No. R-38806 Permit No. R-3288
IN NAME OF

E. E. MARVEL

Surveyed Nov. 15, 1967, by W. J. RUPPERT