


R-2786
27852
G-2278

T.2N.R.13E.W.M.

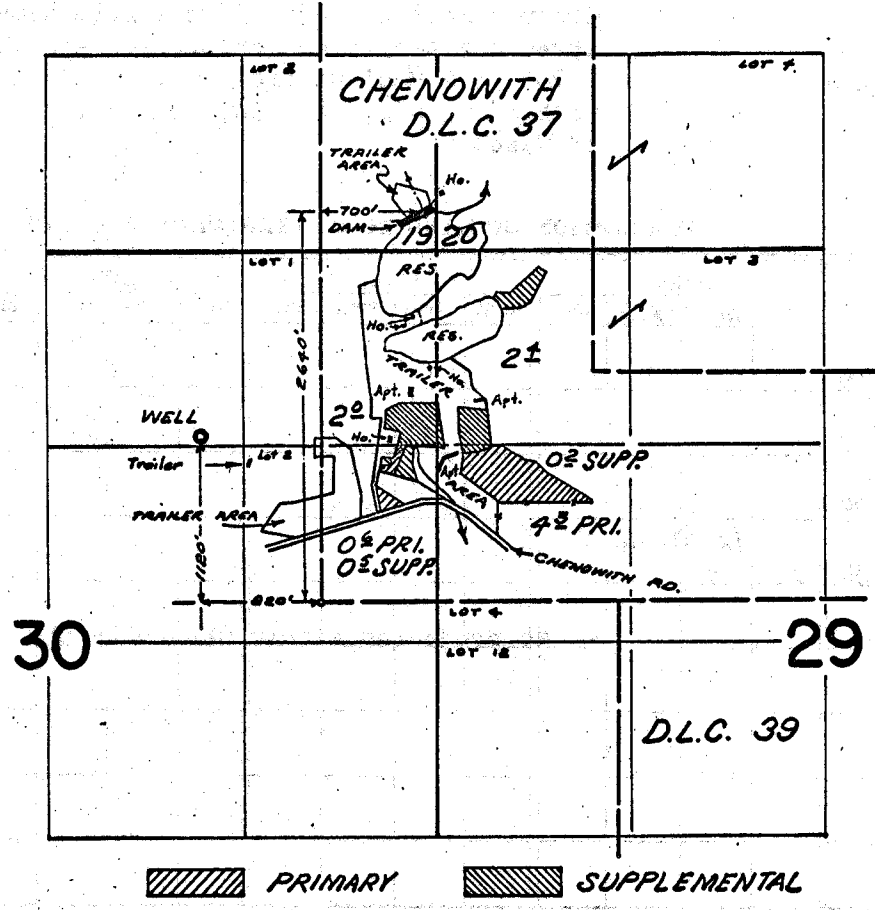

FINAL PROOF SURVEY UNDER

Application No. R-37176 Permit No. R-2786
37177 27852
G-2467 G-2278

IN NAME OF

RUDY R. AND MARJORIE E. WALTERS

Surveyed Nov. 7 1967, by W.J. RUPPERT